



September 21, 2009

Ms. Karen Spray
Colorado Oil & Gas Conservation Commission
P.O. Box 2651
Durango, CO 81302-2651

RE: 4M Installation and Startup Report

Ms. Spray:

LT Environmental, Inc. (LTE) is pleased to submit the Installation and Startup Report for the 4M Outcrop Mitigation Project in La Plata County Colorado to the Colorado Department of Natural Resources (DNR) Colorado Oil & Gas Conservation Commission (COGCC).

Background

The objective of the 4M methane mitigation system is to demonstrate the economical and technical viability to recover and use the uncontrolled methane along the Outcrop. Additional system goals are to operate while helping protect the environment, including reducing carbon emissions and improving plant growth. To accomplish these objectives, LTE designed and installed vapor collection and barrier systems for methane collection at both the South Fork Texas Creek and Pine River sites. At the South Fork Texas Creek site, the recovered methane is being used to run a turbine, which is generating electricity to operate the collection system. The turbine is also returning any excess power to the local electrical grid for credit as a renewable energy resource. The design, installation, and startup of the 4M methane mitigation system was completed in 2008 and 2009 as detailed in this report.

Mitigation System Design

LTE completed a soil vapor survey over the planned methane collection areas in 2008. The survey included use of a flux meter to measure the rate of methane seepage (mole/m²/day). Using the results of the survey, including field measurements and vegetation observations, the mitigation system layout was adjusted to optimize methane collection. Figure 1 and Figure 2 display the methane readings and the system layout for the South Fork Texas Creek site and Pine River site, respectively.

Site 1 for this project is located near the South Fork Texas Creek. To address the seep and optimize recovery of methane, the design for the Texas Creek seep area included installation of a reverse french drain and vapor barrier methane collection system over a 0.8 acre area. The designed collection area focused on areas where methane seepage was more prevalent as identified by previous field studies. Four collection areas were utilized.



Site 2 for this project is located near the Pine River. To address the seep and optimize recovery of methane, the design for the Pine River seep area included installation of a reverse french drain methane collection system over 0.7 acres utilizing four collection areas. In an effort to focus on areas where methane seepage was more prevalent and minimize oxygen recovery, some lengths of piping were solid while others were slotted, depending on the data collected during previous field studies.

Mitigation System Installation

In each of the South Fork Texas Creek collection areas, soil was removed to a depth of approximately 18-inches. Corrugated slotted drain piping was installed on 20-25 foot centers throughout the collection areas. The entire collection area was filled with approximately 9 inches of 3/8-1/2 inch gravel, and a 15-mil vapor barrier was installed over the rock. On top of the vapor barrier, soil was replaced and the area was seeded with a native mix.

At the Pine River collection areas, soil was removed to a depth of approximately 18-inches, where piping (both slotted and solid) was installed on 15 foot centers. Only the trenches where the piping was laid were filled with approximately 9 inches of 3/8-1/2 inch gravel under a 15-mil vapor barrier. On top of the vapor barrier, soil was replaced and the area was seeded with a native mix.

The horizontal collection piping at both sites was connected to header piping, which was connected to a valve manifold. Sampling ports allow for collection and analytical testing of the gas for each of the four collection areas. The valves allow for flow adjustment, making it possible to focus on the more productive areas for gas collection.

At both sites, the gas mixture is treated to remove moisture and filtered before being compressed. The process equipment is located in a small building on a concrete pad. At the South Fork Texas Creek site, the turbine is located in a separate building to isolate the gas collection and use components for safety. Each system includes a continuous methane and oxygen concentration detector. The sensors are connected to controls and are utilized to shut down the process equipment if the gas mixture is not able to be safely used to power the turbine or if the gas quality falls near the upper explosive range. A list of major equipment components is provided on Table 1.

At the South Fork Texas Creek site, a 30 kilowatt (kW) turbine fueled by the collected gas is utilized to create enough electricity to operate the collection equipment. The system is connected to the power grid allowing for the excess generated electricity to be returned to the grid.

The subsurface piping and vapor barriers were installed and the concrete building pads were poured during October 2008. The installation area was then seeded and straw covered in November 2008, prior to winter weather. Work was discontinued while mineral rights clarification and approval of the final access and use agreement by British Petroleum (BP) and the COGCC was accomplished. Over the winter months (November 2008 through March 2009), equipment was ordered. Installation of the remediation system equipment was completed from April 8, 2009 through May 7, 2009. The As-Built Drawings for both sites are included as Attachment 1.



Mitigation System Startup

Startup testing was accomplished May 5, 2009 through May 7, 2009 at both the South Fork Texas Creek and Pine River sites.

South Fork Texas Creek

During the startup, the turbine was gradually ramped up from the initial 2 kilowatt (KW) setting on May 5 to a rate of 10 KW on May 7. The system was able to sustain operation without disruption due to vacuum/pressure or gas quality issues with the turbine running at 10 KW. Normal system operation utilizes approximately 6 KW of electrical power, allowing the remaining 4 KW to be placed back into the grid for a net gain with regards to electrical consumption.

During startup, gas quality was observed to consist of approximately 80% methane in three of the four collection zones, with zone four having readings of approximately 60% methane. However, after allowing the system to operate constantly over the startup period, the gas quality in all four zones exhibited methane levels of approximately 80%. At the conclusion of startup, all four zones were utilized for gas collection.

During startup activities, LTE personnel identified grass growing in areas previously prohibitive of vegetative growth. Visual observations also identified that the level of gas bubbling through the South Fork Texas Creek had seemingly increased since the installation of the subsurface system. The observed increase in both the vegetative growth and the escaping gas is believed to be due to the installation of the vapor barrier in the four collection areas.

Pine River

Gas quality was observed to fluctuate between 30% and 40% methane in the four collection zones during startup. Because lower methane concentrations are not conducive to combustion, the mitigation system blower was utilized to vent the methane to the atmosphere. If future operations show higher methane levels, electrical generation equipment similar to that at the South Fork Texas Creek site could be installed.

Summary and Conclusions

Current operation suggests that the design, installation, and startup of the methane mitigation system were successful. Visual observations (vegetation and creek) and field readings (gas quality and electrical generation) lend credence to the success of the mitigation system. The next phase of the methane mitigation system will consist of operation and continued monitoring. During that time, normal operation and maintenance activities will be performed, as well as system optimization.



LTE appreciates the opportunity to provide services to the COGCC. Please call us at 303-433-9788 if you have any questions or comments regarding this report.

Sincerely,

LT ENVIRONMENTAL, INC.

A handwritten signature in black ink, appearing to read 'Matthew Vielhaber', written in a cursive style.

Matthew R. Vielhaber, P.E.
Project Engineer

A handwritten signature in black ink, appearing to read 'Chris Shephard', written in a cursive style.

Christopher E. Shephard, P.E.
Principal/Group Manager

Attachments: Table 1 – Major Equipment List
Figure 1 – South Fork Texas Creek Site Layout
Figure 2 – Pine River Site Layout
As-Built Drawings

TABLE



**TABLE 1
MAJOR EQUIPMENT LIST**

	Equipment	As-Built Drawing	Quantity	Manufacturer	Model	Specifications
South Fork Texas Creek	KO Tank	P100	1	Busch	U8	
	Gas Compressor (M-1)	P100	1	Capstone	Gas-Pac	16 cfm @ 80 psig
	Dryer	P100	1	N/A	N/A	
	Electrical Generator (M-2)	P100	1	Capstone	C30	Natural Gas, Grid Connect, 30 kW, Turbine Driven, Industrial Package
Pine River	KO Tank	P200	1	N/A	N/A	
	Gas Blower (M-3)	P200	1	Gast	R3105N-50	28 in wc max vacuum, 1/3 Hp

NOTE:

cfm - cubic feet per minute

in wc - inches water column

psig - pounds per square inch gauge

Hp - horsepower


kW - kilowatt

N/A - not available



FIGURES



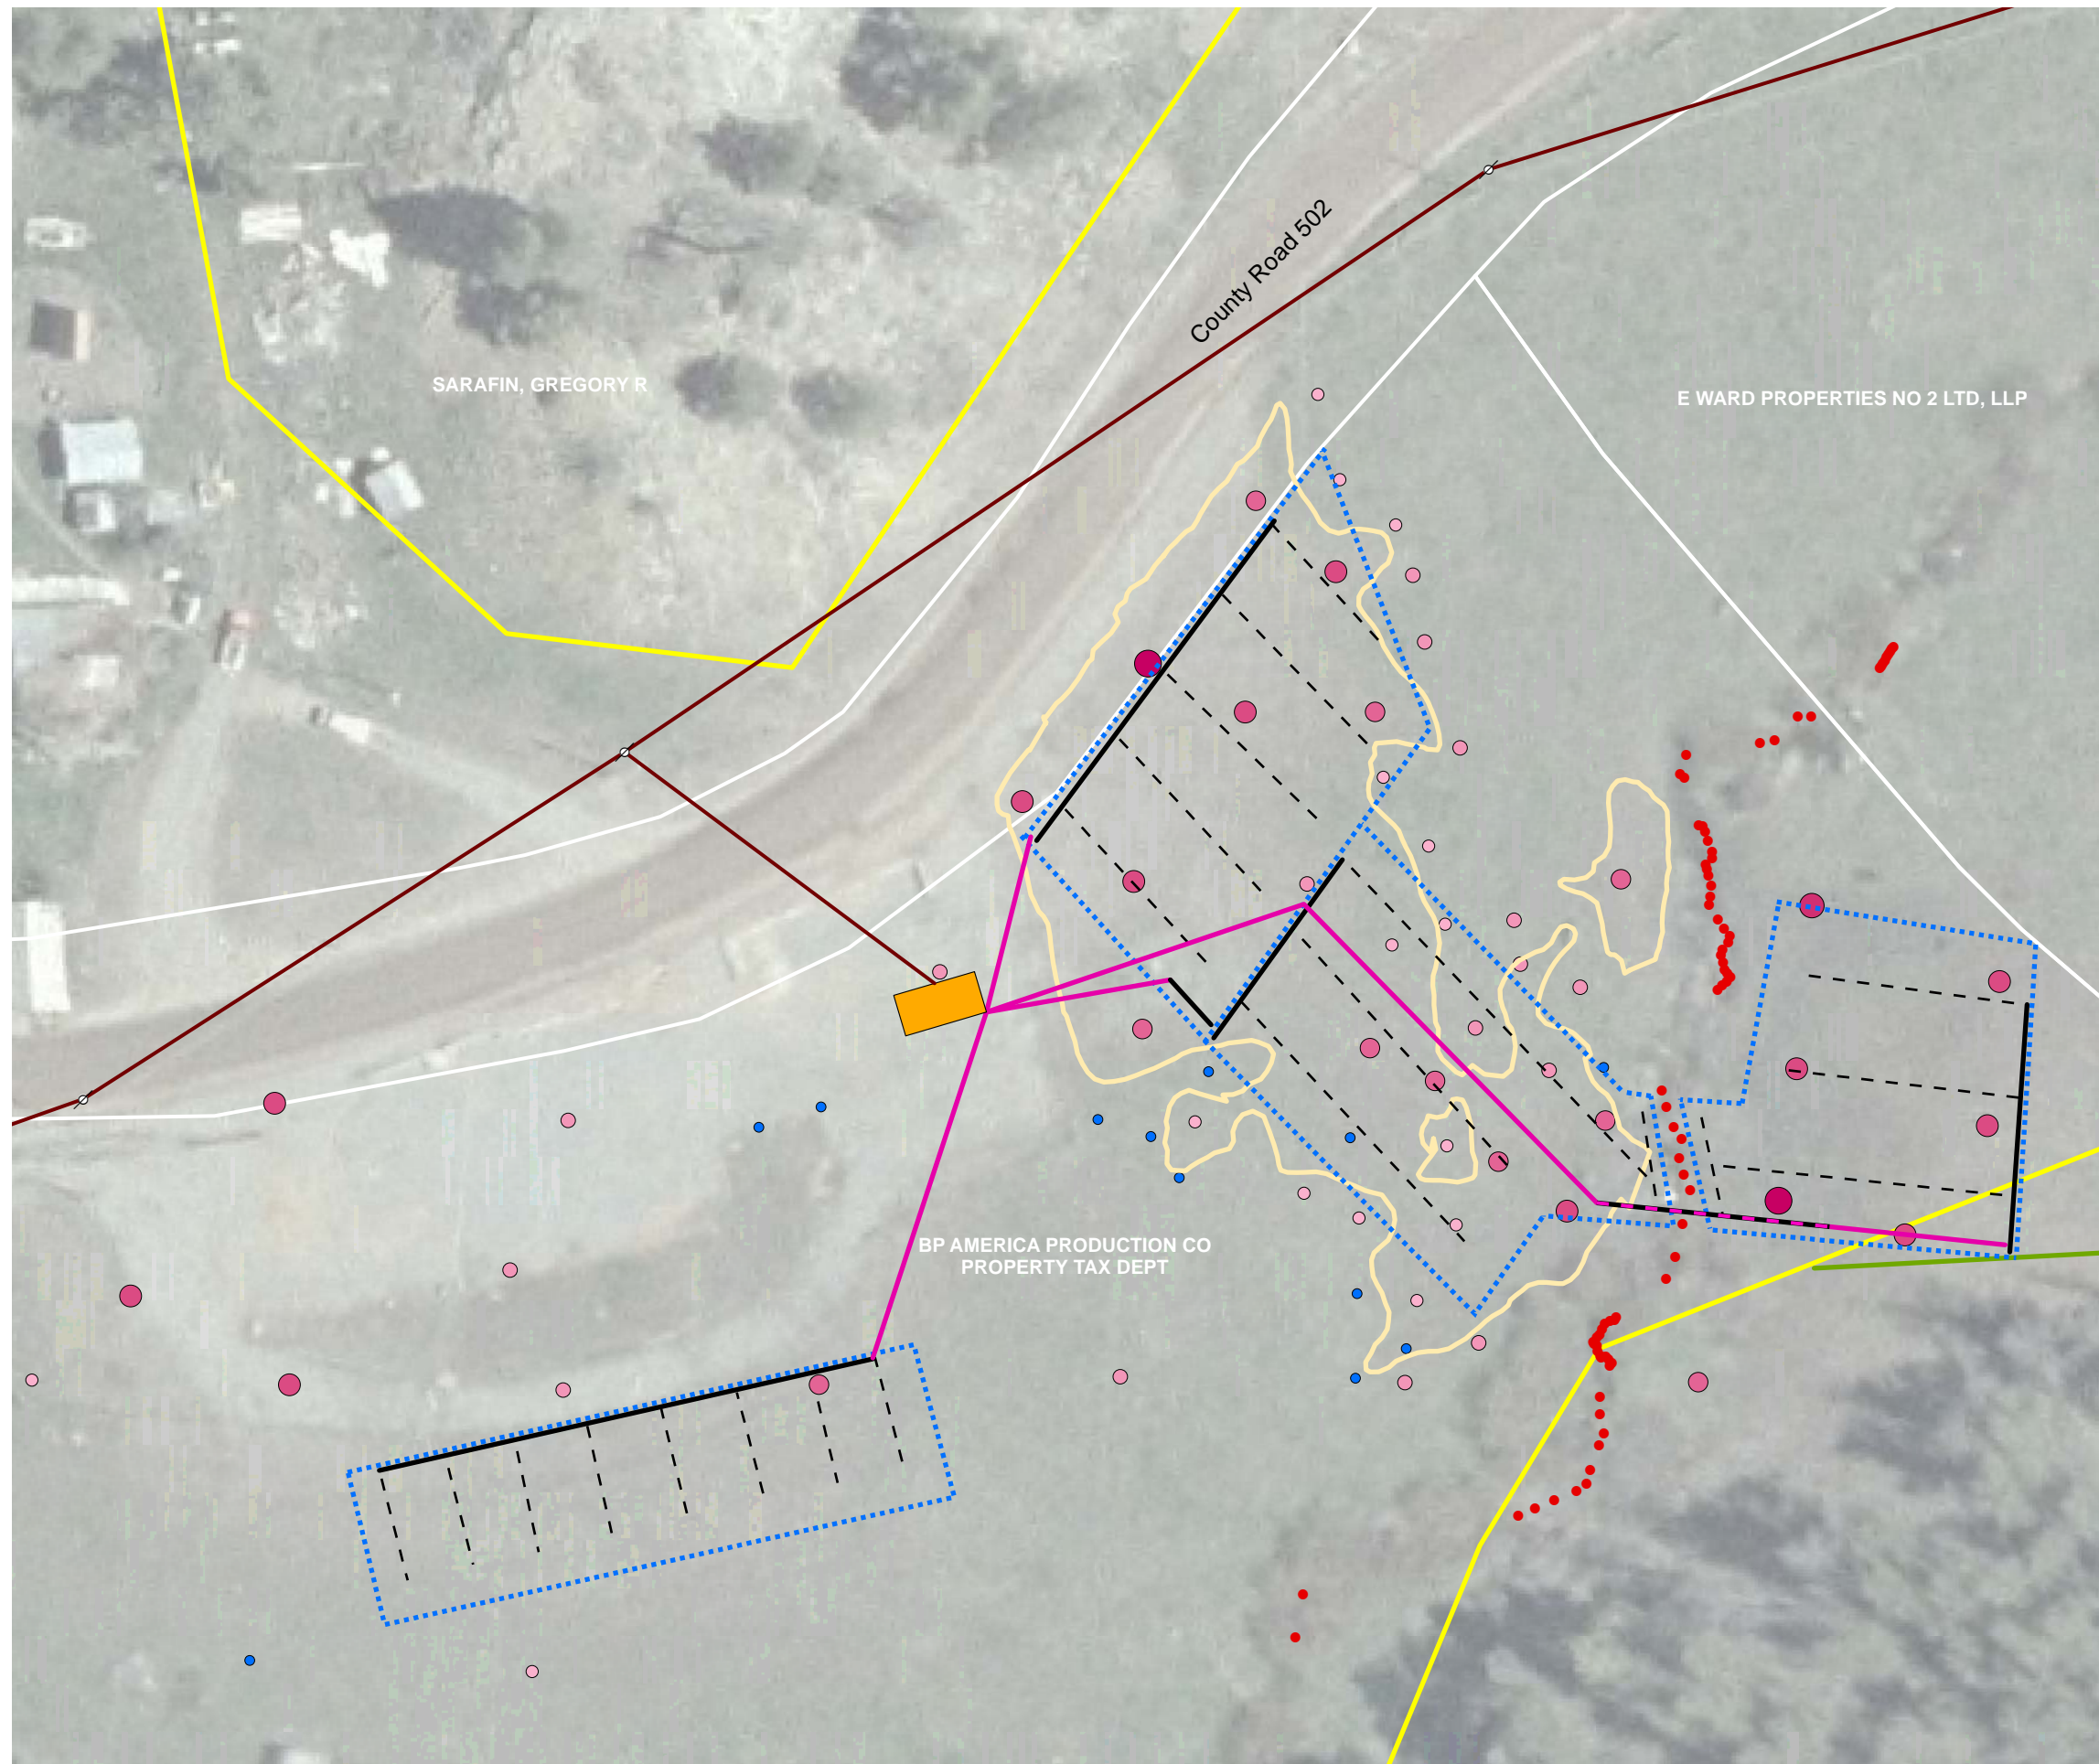

LEGEND

- Visible Methane Seeps in Surface Water
- ✚ Gas Monitoring Probes
- Process Equipment Footprint
- Methane Flux Results (mole/m²/day)**
- 0.00000
- 0.00001 - 0.10000
- 0.10001 - 0.50000
- 0.50001 - 1.00000
- 1.00001 - 10.00000
- 10.00001 - 50.00000
- 50.00001 - 100.00000
- 100.00001 - 1175.00000
- Overhead Electrical Line
- ⋯ 15 mil Impervious Membrane
- Parcel Boundary & Owner (white)
- ▭ Stressed Vegetation
- Piping**
- 3" SCH 40 PVC
- 3" SCH 80 PVC
- - 4" ADS Corrugated Piping (Slotted)
- 4" ADS Corrugated Piping (Solid)
- Geology**
- Fruitland Formation (Kf)
- Fruitland Formation Tongue (Kft)
- Kirtland Formation (Kk)
- Pictured Cliffs Formation (Kpc)
- Pictured Cliffs Formation Tongue (Kpct)
- Quaternary Alluvium (Qa)
- Quaternary Gravel (Qg)

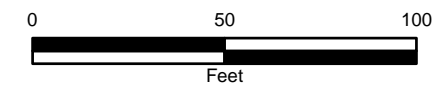


FIGURE 1
SITE LAYOUT
SOUTH FORK TEXAS CREEK
4M OUTCROP MITIGATION
DURANGO, COLORADO





- LEGEND**
- Visible Methane Seeps in Surface Water
 - ⊕ Gas Monitoring Probes
 - ⊘ Power Pole
 - Process Equipment Footprint
 - Stressed Vegetation
 - Parcel Boundary & Owner (white)
 - Power Line
- Methane Flux Results (mole/m²/day)**
- 0.00000
 - 0.00140 - 0.10000
 - 0.16615 - 0.50000
 - 0.52514 - 1.00000
 - 1.09969 - 10.00000
 - 10.98770 - 50.00000
 - 100.00000
 - 1175.00000
- Piping**
- 3" SCH 40 PVC
 - - 4" ADS Corrugated Piping (Slotted)
 - 4" ADS Corrugated Piping (Solid)
- Geology**
- Fruitland Formation (Kf)
 - Fruitland Formation Tongue (Kft)
 - Kirtland Formation (Kk)
 - Pictured Cliffs Formation (Kpc)
 - Pictured Cliffs Formation Tongue (Kpct)
 - Quaternary Alluvium (Qa)
 - Quaternary Gravel (Qg)

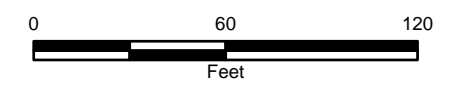


FIGURE 2
SITE LAYOUT
PINE RIVER
4M OUTCROP MITIGATION
DURANGO, COLORADO



AS-BUILT DRAWINGS



COLORADO OIL AND GAS CONSERVATION COMMISSION
4M OUTCROP MITIGATION
DURANGO, CO

AS-BUILT DRAWINGS

G100 TITLE SHEET AND INDEX OF DRAWINGS

SITE 1 – SOUTH FORK TEXAS CREEK


C100 MITIGATION PIPING LAYOUT
C101 PIPING DIAGRAM
C102 PIPING AT CREEK CROSSING
C103 CONCRETE PAD DETAILS
C104 EQUIPMENT BUILDING DETAILS


P100 PROCESS FLOW AND INSTRUMENTATION DIAGRAM
P101 VALVE MANIFOLD
P102 PROCESS EQUIPMENT LAYOUT

SITE 2 – PINE RIVER

C200 MITIGATION PIPING LAYOUT
C201 PIPING DIAGRAM
C202 CONCRETE PAD DETAILS
C203 EQUIPMENT BUILDING DETAILS

P200 PROCESS FLOW AND INSTRUMENTATION DIAGRAM
P201 VALVE MANIFOLD
P202 PROCESS EQUIPMENT LAYOUT


NO.	DESCRIPTION	BY	APPROVED	DATE	DRAWING INFORMATION	BY	DATE	 <small>LT Environmental, Inc. Denver, Colorado</small> Compliance • Engineering • Remediation	TITLE SHEET AND INDEX OF DRAWINGS 4M OUTCROP MITIGATION DURANGO, COLORADO
	REVISIONS								
C	AS-BUILT	MRV	CES	9/4/09	DESIGNED	MRV	9/4/09	PROJECT LOCATION: DURANGO, COLORADO CLIENT: COLORADO OIL AND GAS CONSERVATION COMMISSION PROJECT NO. OGCC0801 REV NO. C DWG NO. G100	
B	FINAL DESIGN	MRV	CES	10/1/08	DRAWN	GVM	9/4/09		
A	PRELIMINARY DESIGN	MRV	CES	7/14/08	CHECKED	MRV	9/4/09		
					REVIEWED	CES	9/4/09		
					APPROVED	CES	9/4/09		
					FILE: OGCC081\AS-BUILT\G100 SCALE: AS SHOWN				

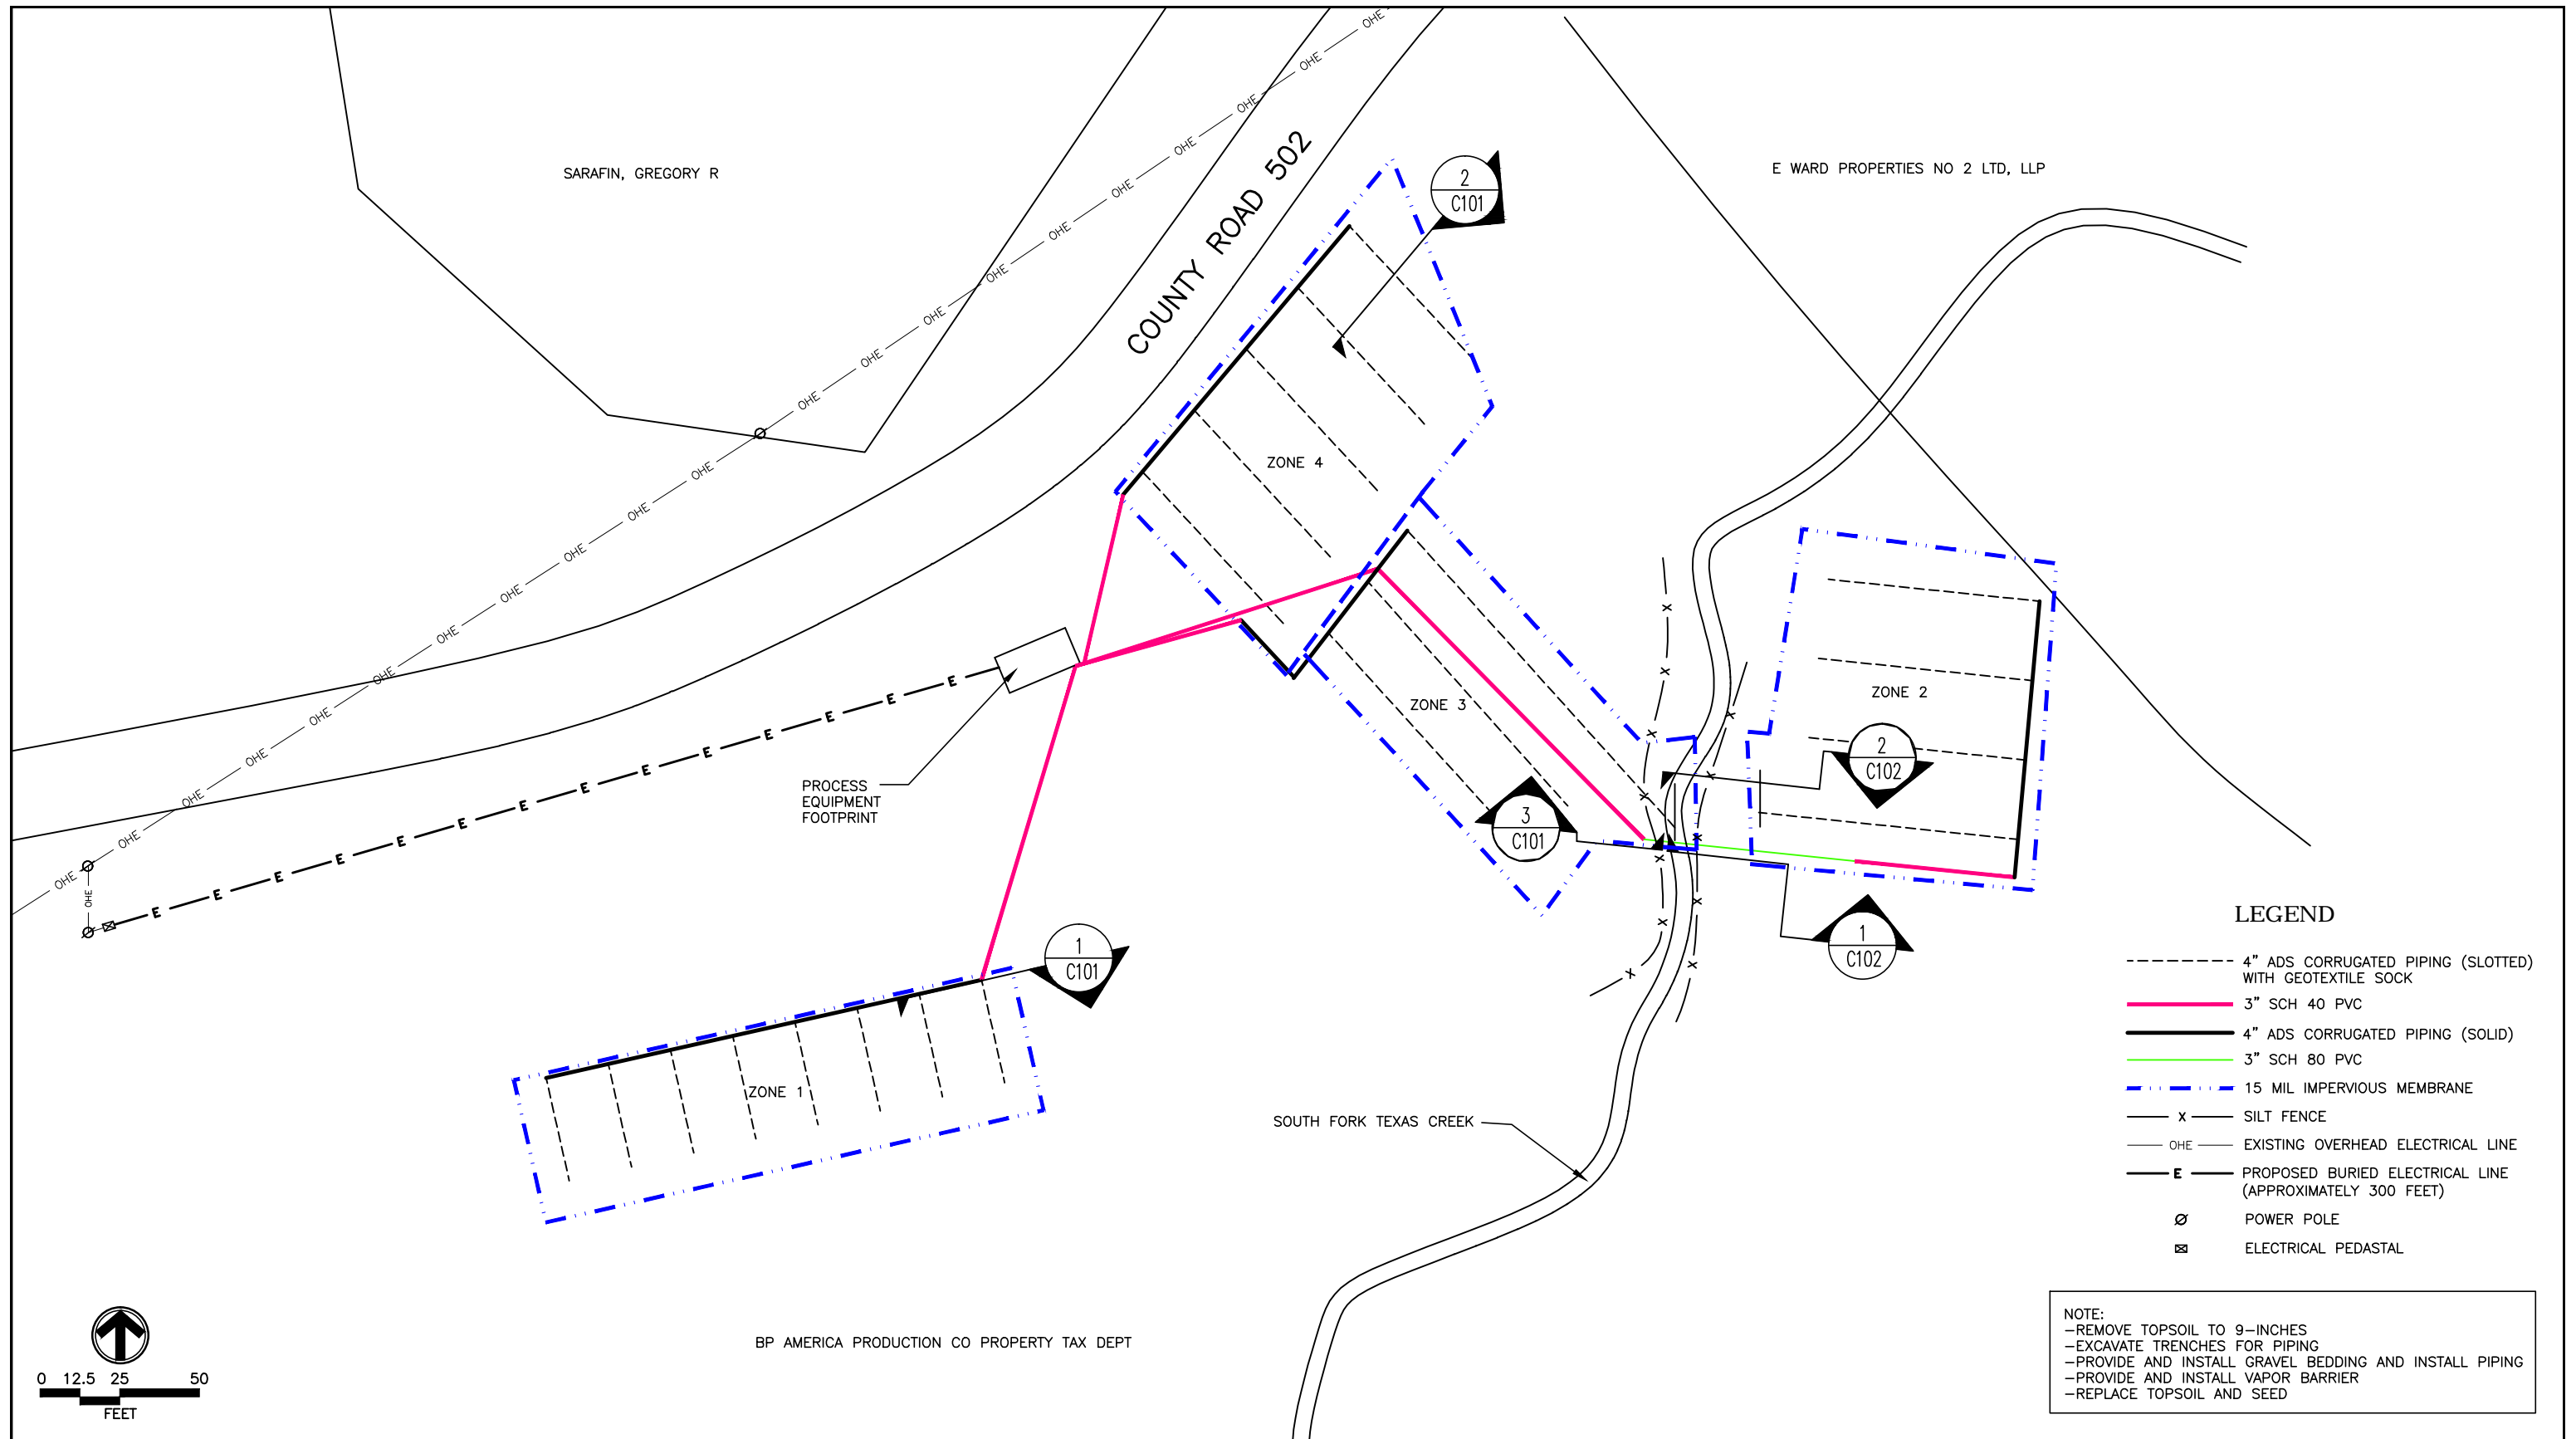

LEGEND

- 4" ADS CORRUGATED PIPING (SLOTTED) WITH GEOTEXTILE SOCK
- 3" SCH 40 PVC
- 4" ADS CORRUGATED PIPING (SOLID)
- 3" SCH 80 PVC
- 15 MIL IMPERVIOUS MEMBRANE
- x — SILT FENCE
- OHE — EXISTING OVERHEAD ELECTRICAL LINE
- E — PROPOSED BURIED ELECTRICAL LINE (APPROXIMATELY 300 FEET)
- ⊙ POWER POLE
- ⊠ ELECTRICAL PEDASTAL

NOTE:
 -REMOVE TOPSOIL TO 9-INCHES
 -EXCAVATE TRENCHES FOR PIPING
 -PROVIDE AND INSTALL GRAVEL BEDDING AND INSTALL PIPING
 -PROVIDE AND INSTALL VAPOR BARRIER
 -REPLACE TOPSOIL AND SEED

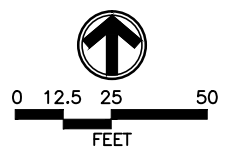

REVISIONS				
NO.	DESCRIPTION	BY	APPROVED	DATE
C	AS-BUILT	MRV	CES	9/4/09
B	FINAL DESIGN	MRV	CES	10/1/08
A	PRELIMINARY DESIGN	MRV	CES	7/14/08


BP AMERICA PRODUCTION CO PROPERTY TAX DEPT

DRAWING INFORMATION		
BY	DATE	
DESIGNED MRV	9/4/09	
DRAWN GVM	9/4/09	
CHECKED MRV	9/4/09	
REVIEWED CES	9/4/09	
APPROVED CES	9/4/09	
FILE: OGCC081\AS-BUILT\C100		
SCALE: AS SHOWN		




**MITIGATION PIPING LAYOUT
 SITE 1 - SOUTH FORK TEXAS CREEK
 4M OUTCROP MITIGATION
 DURANGO, COLORADO**


PROJECT LOCATION: DURANGO, COLORADO		PROJECT NO. OGCC0801
CLIENT: COLORADO OIL AND GAS CONSERVATION COMMISSION	REV NO. C	DWG NO. C100

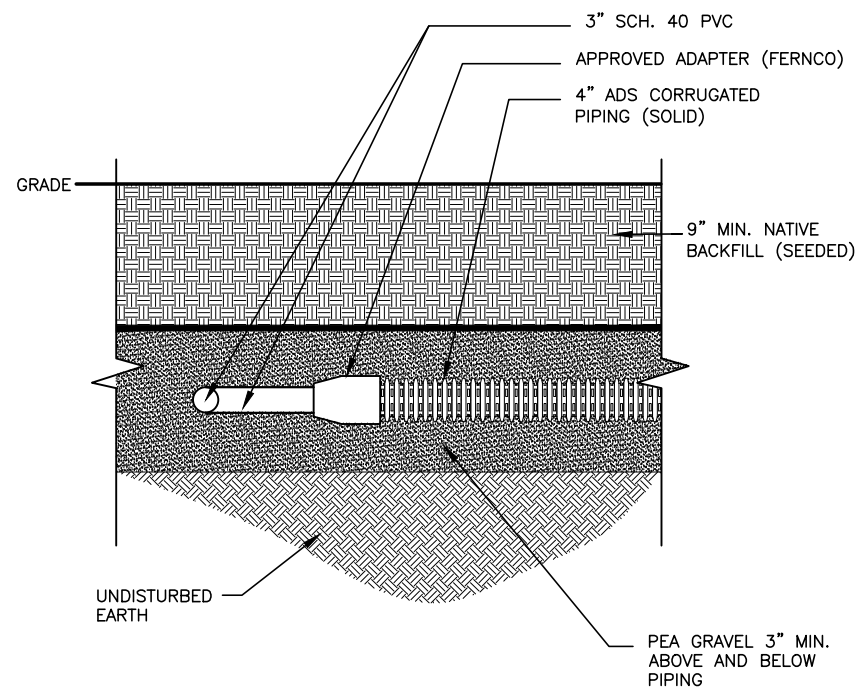

1 PIPING CONNECTION AT HEADER
C101 SCALE: 1" = 1'-0"

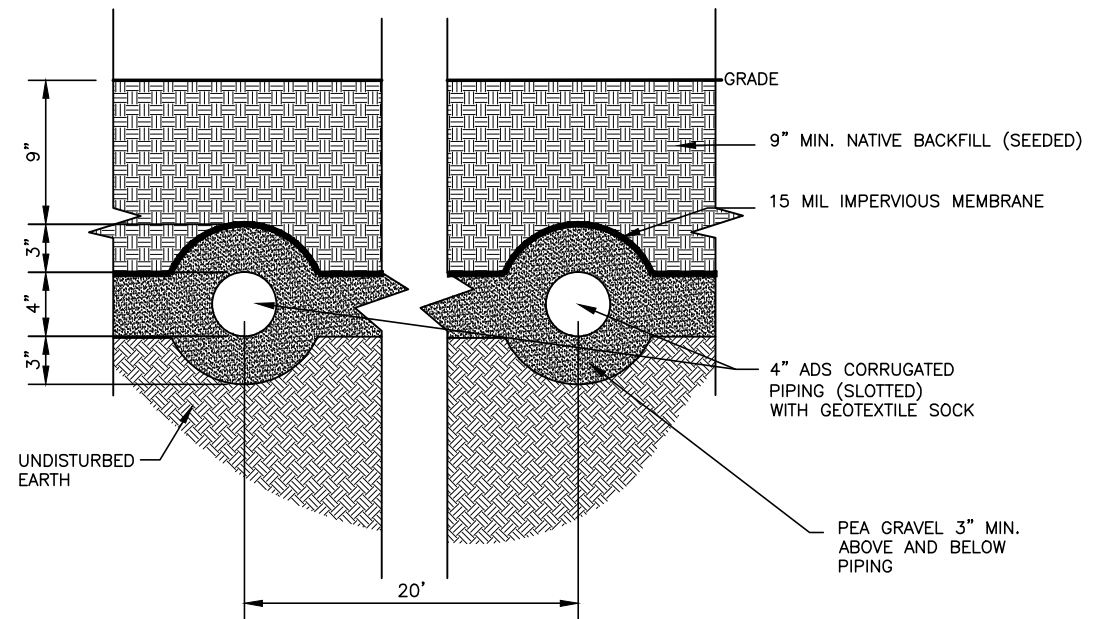

2 HORIZONTAL VENT LINE CROSS SECTION
C101 SCALE: 1" = 1'-0"

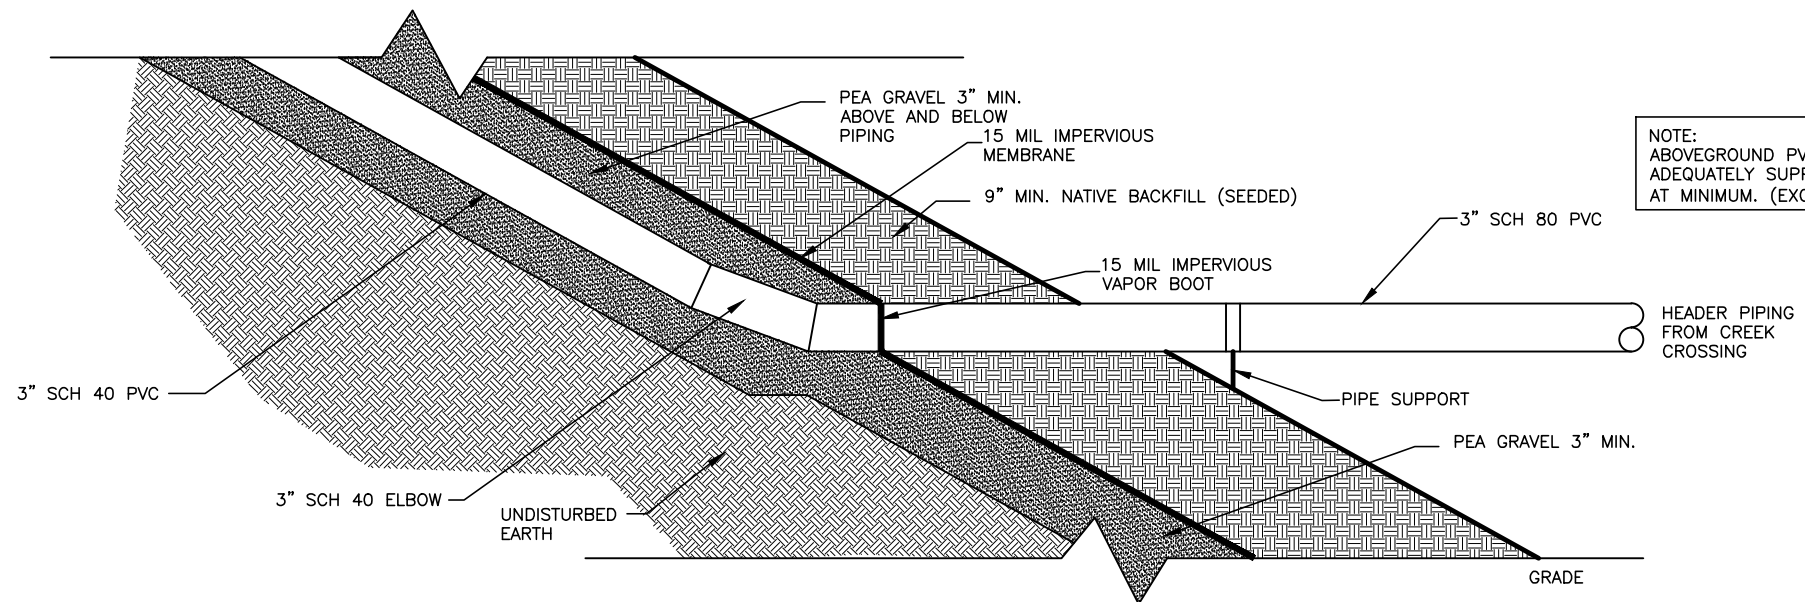

3 HEADER CONNECTION FROM CREEK CROSSING
C101 SCALE: 1" = 1'-0"

NOTE:
ABOVEGROUND PVC PIPING SHOULD BE
ADEQUATELY SUPPORTED EVERY 6 FOOT
AT MINIMUM. (EXCEPT OVER CREEK)

REVISIONS				
NO.	DESCRIPTION	BY	APPROVED	DATE
C	AS-BUILT	MRV	CES	9/4/09
B	FINAL DESIGN	MRV	CES	10/1/08
A	PRELIMINARY DESIGN	MRV	CES	7/14/08


DRAWING INFORMATION	BY	DATE
DESIGNED	MRV	9/4/09
DRAWN	GVM	9/4/09
CHECKED	MRV	9/4/09
REVIEWED	CES	9/4/09
APPROVED	CES	9/4/09

FILE: OGCC081\AS-BUILT\ C101
SCALE: AS SHOWN




PIPING DIAGRAM SITE 1 - SOUTH FORK TEXAS CREEK 4M OUTCROP MITIGATION DURANGO, COLORADO		
PROJECT LOCATION: DURANGO, COLORADO	PROJECT NO. OGCC0801	
CLIENT: COLORADO OIL AND GAS CONSERVATION COMMISSION	REV NO. C	DWG NO. C101

NOTE:
ABOVEGROUND PVC PIPING SHOULD BE
ADEQUATELY SUPPORTED EVERY 6 FOOT
AT MINIMUM. (EXCEPT OVER CREEK)

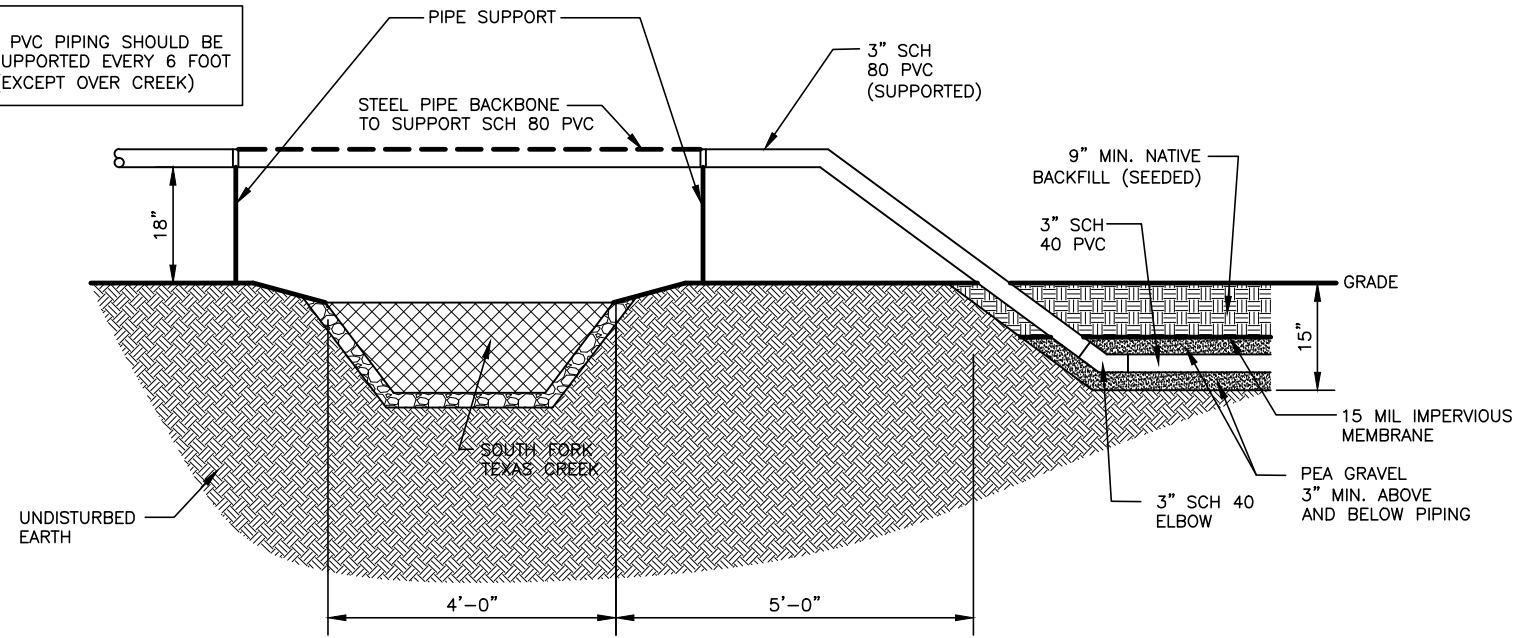

1 HEADER PIPING AT CREEK CROSSING
C102 SCALE: NOT TO SCALE

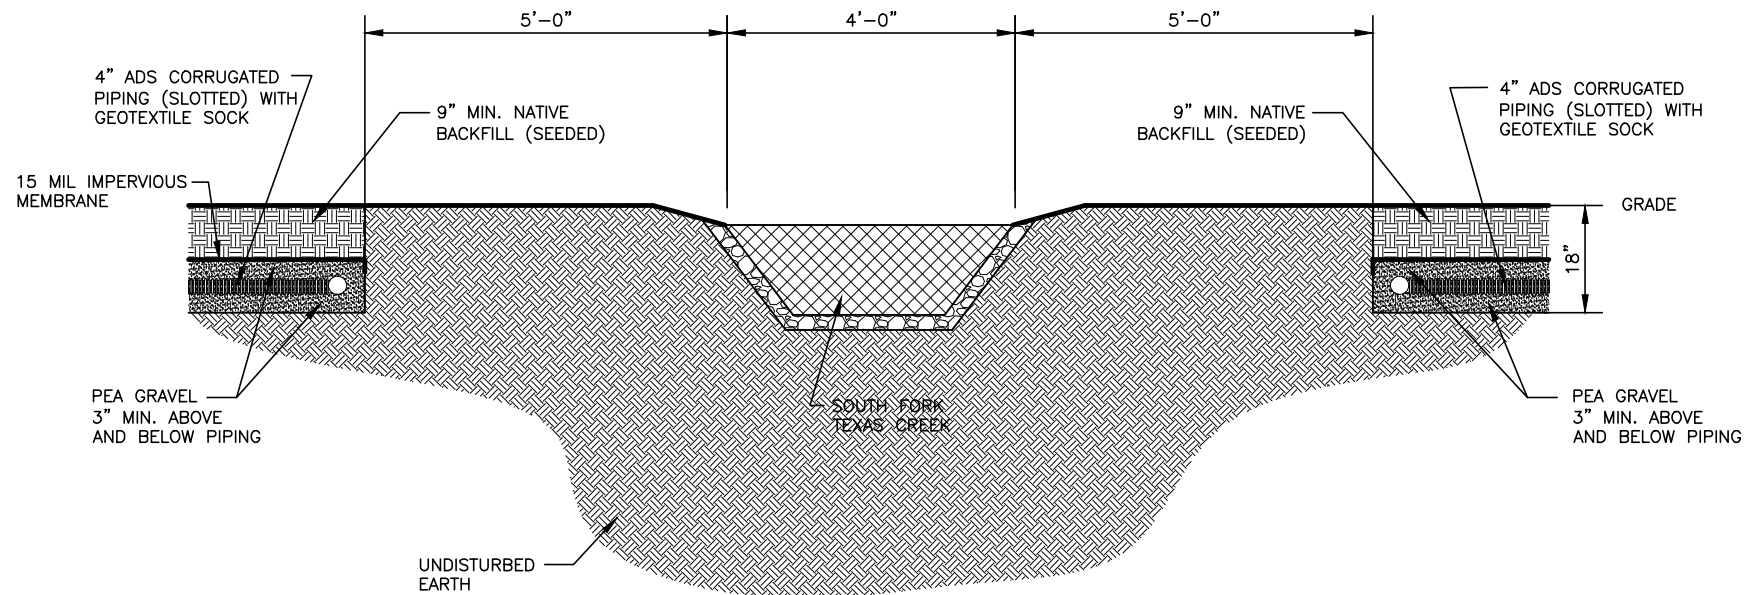

2 HORIZONTAL VENT LINE AT CREEK CROSSING
C102 SCALE: NOT TO SCALE


REVISIONS				
NO.	DESCRIPTION	BY	APPROVED	DATE
C	AS-BUILT	MRV	CES	9/4/09
B	FINAL DESIGN	MRV	CES	10/1/08
A	PRELIMINARY DESIGN	MRV	CES	7/14/08

DRAWING INFORMATION	BY	DATE
DESIGNED	MRV	9/4/09
DRAWN	GVM	9/4/09
CHECKED	MRV	9/4/09
REVIEWED	CES	9/4/09
APPROVED	CES	9/4/09

FILE: OGCC081\AS-BUILT\C101
SCALE: AS SHOWN



PIPING AT CREEK CROSSING SITE 1 - SOUTH FORK TEXAS CREEK 4M OUTCROP MITIGATION DURANGO, COLORADO		
PROJECT LOCATION: DURANGO, COLORADO	PROJECT NO. OGCC0801	
CLIENT: COLORADO OIL AND GAS CONSERVATION COMMISSION	REV NO. C	DWG NO. C102

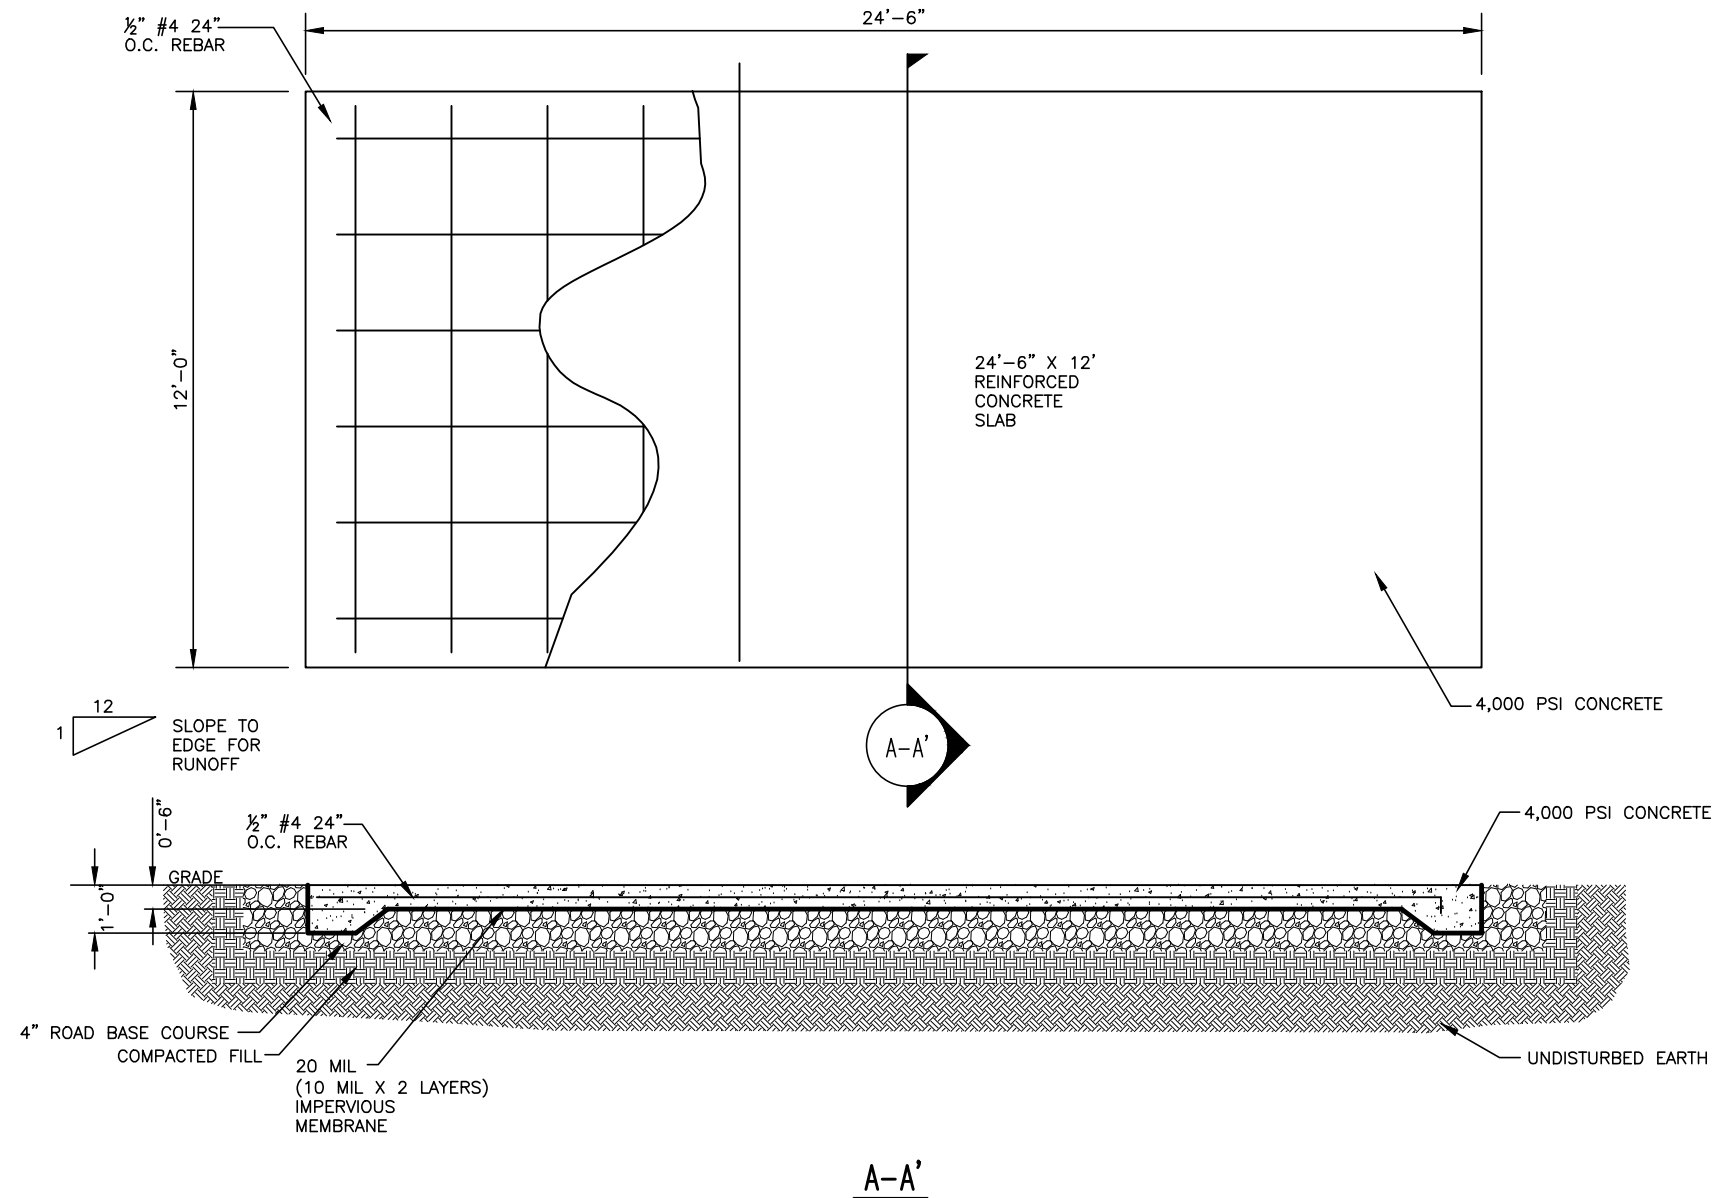

1
C103 CONCRETE PADS DETAILS
SCALE: 1/4" = 1'-0"



REVISIONS				
NO.	DESCRIPTION	BY	APPROVED	DATE
C	AS-BUILT	MRV	CES	9/4/09
B	FINAL DESIGN	MRV	CES	10/1/08
A	PRELIMINARY DESIGN	MRV	CES	7/14/08

DRAWING INFORMATION	BY	DATE
DESIGNED	MRV	9/4/09
DRAWN	GVM	9/4/09
CHECKED	MRV	9/4/09
REVIEWED	CES	9/4/09
APPROVED	CES	9/4/09

FILE: OGCC081\AS-BUILT\C102
SCALE: AS SHOWN



CONCRETE PAD DETAILS SITE 1 – SOUTH FORK TEXAS CREEK 4M OUTCROP MITIGATION DURANGO, COLORADO		
PROJECT LOCATION: DURANGO, COLORADO	PROJECT NO. OGCC0801	
CLIENT: COLORADO OIL AND GAS CONSERVATION COMMISSION	REV NO. C	DWG NO. C103

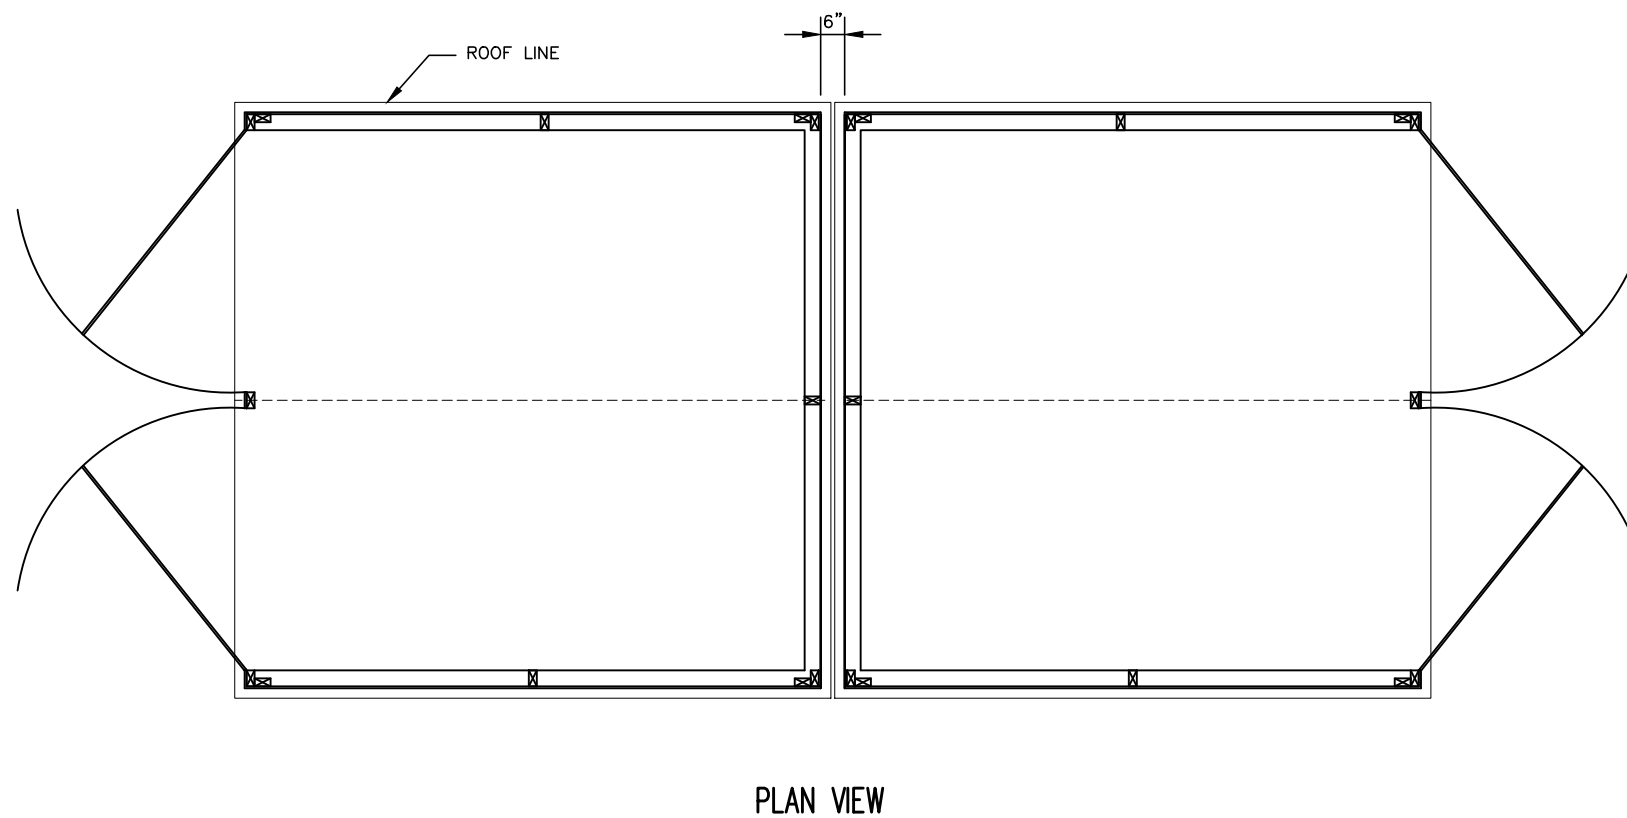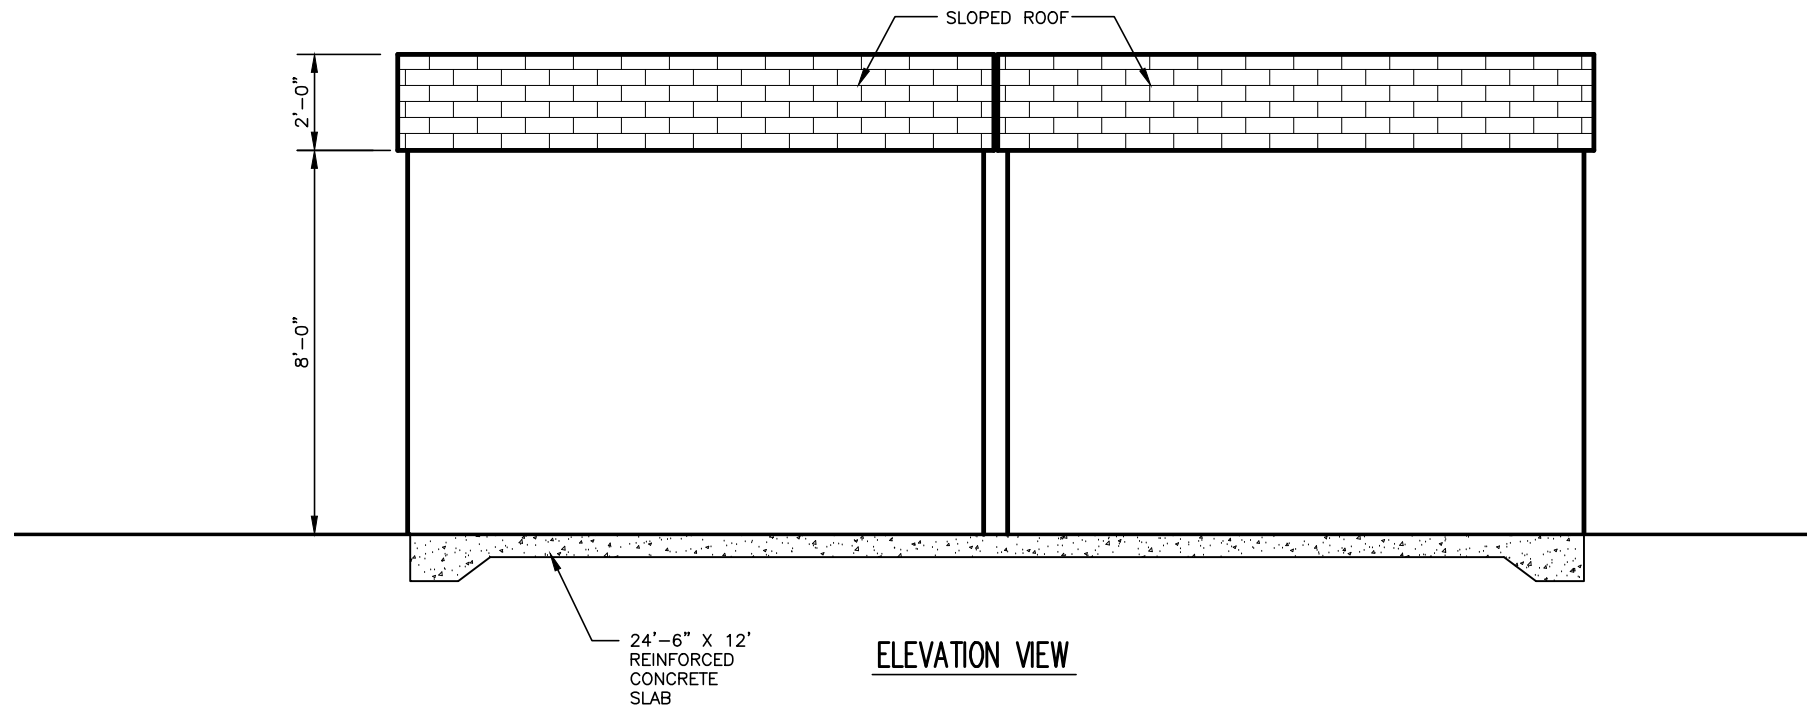

2
C104

EQUIPMENT BUILDING
SCALE: 1/4" = 1'-0"

NOTE:
 -PROVIDE AND ATTACH "NO SMOKING" SIGNAGE TO BUILDING
 -PROVIDE APPROPRIATE FIRE EXTINGUISHER FOR SITE
 -PROVIDE INSULATION FOR ACOUSTICAL DAMPENING
 -ANCHOR BUILDINGS TO CONCRETE PER MANUFACTURER RECOMMENDATIONS
 -ADEQUATE VENTILATION SHALL BE PROVIDED FOR BOTH BUILDINGS

REVISIONS				
NO.	DESCRIPTION	BY	APPROVED	DATE
C	AS-BUILT	MRV	CES	9/4/09
B	FINAL DESIGN	MRV	CES	10/1/08
A	PRELIMINARY DESIGN	MRV	CES	7/14/08

DRAWING INFORMATION	BY	DATE
DESIGNED	MRV	9/4/09
DRAWN	GVM	9/4/09
CHECKED	MRV	9/4/09
REVIEWED	CES	9/4/09
APPROVED	CES	9/4/09


FILE: OGCC081\AS-BUILT\ C103
 SCALE: AS SHOWN



EQUIPMENT BUILDING DETAILS SITE 1 - SOUTH FORK TEXAS CREEK 4M OUTCROP MITIGATION DURANGO, COLORADO		
PROJECT LOCATION: DURANGO, COLORADO	PROJECT NO. OGCC0801	
CLIENT: COLORADO OIL AND GAS CONSERVATION COMMISSION	REV NO. C	DWG NO. C104

LEGEND

- BALL VALVE (NO)
- BALL VALVE (NC)
- SOLENOID VALVE (NO)
- SOLENOID VALVE (NC)
- PRESSURE REGULATING VALVE
- 1/2" PLUGGED SAMPLING PORT
- UNION
- KNOCKOUT TANK
- COALESCING FILTER
- CSP
- PVC
- MOTOR
- VACUUM INDICATOR
- TEMPERATURE SWITCH
- HIGH LEVEL SWITCH
- FLOW INDICATOR/TOTALIZER
- GAS MONITOR
- PRESSURE SWITCH
- VACUUM SWITCH
- ELECTRICAL CONNECTION
- DRYER
- COMPRESSOR
- INTERLOCK ELECTRICAL CONTROL

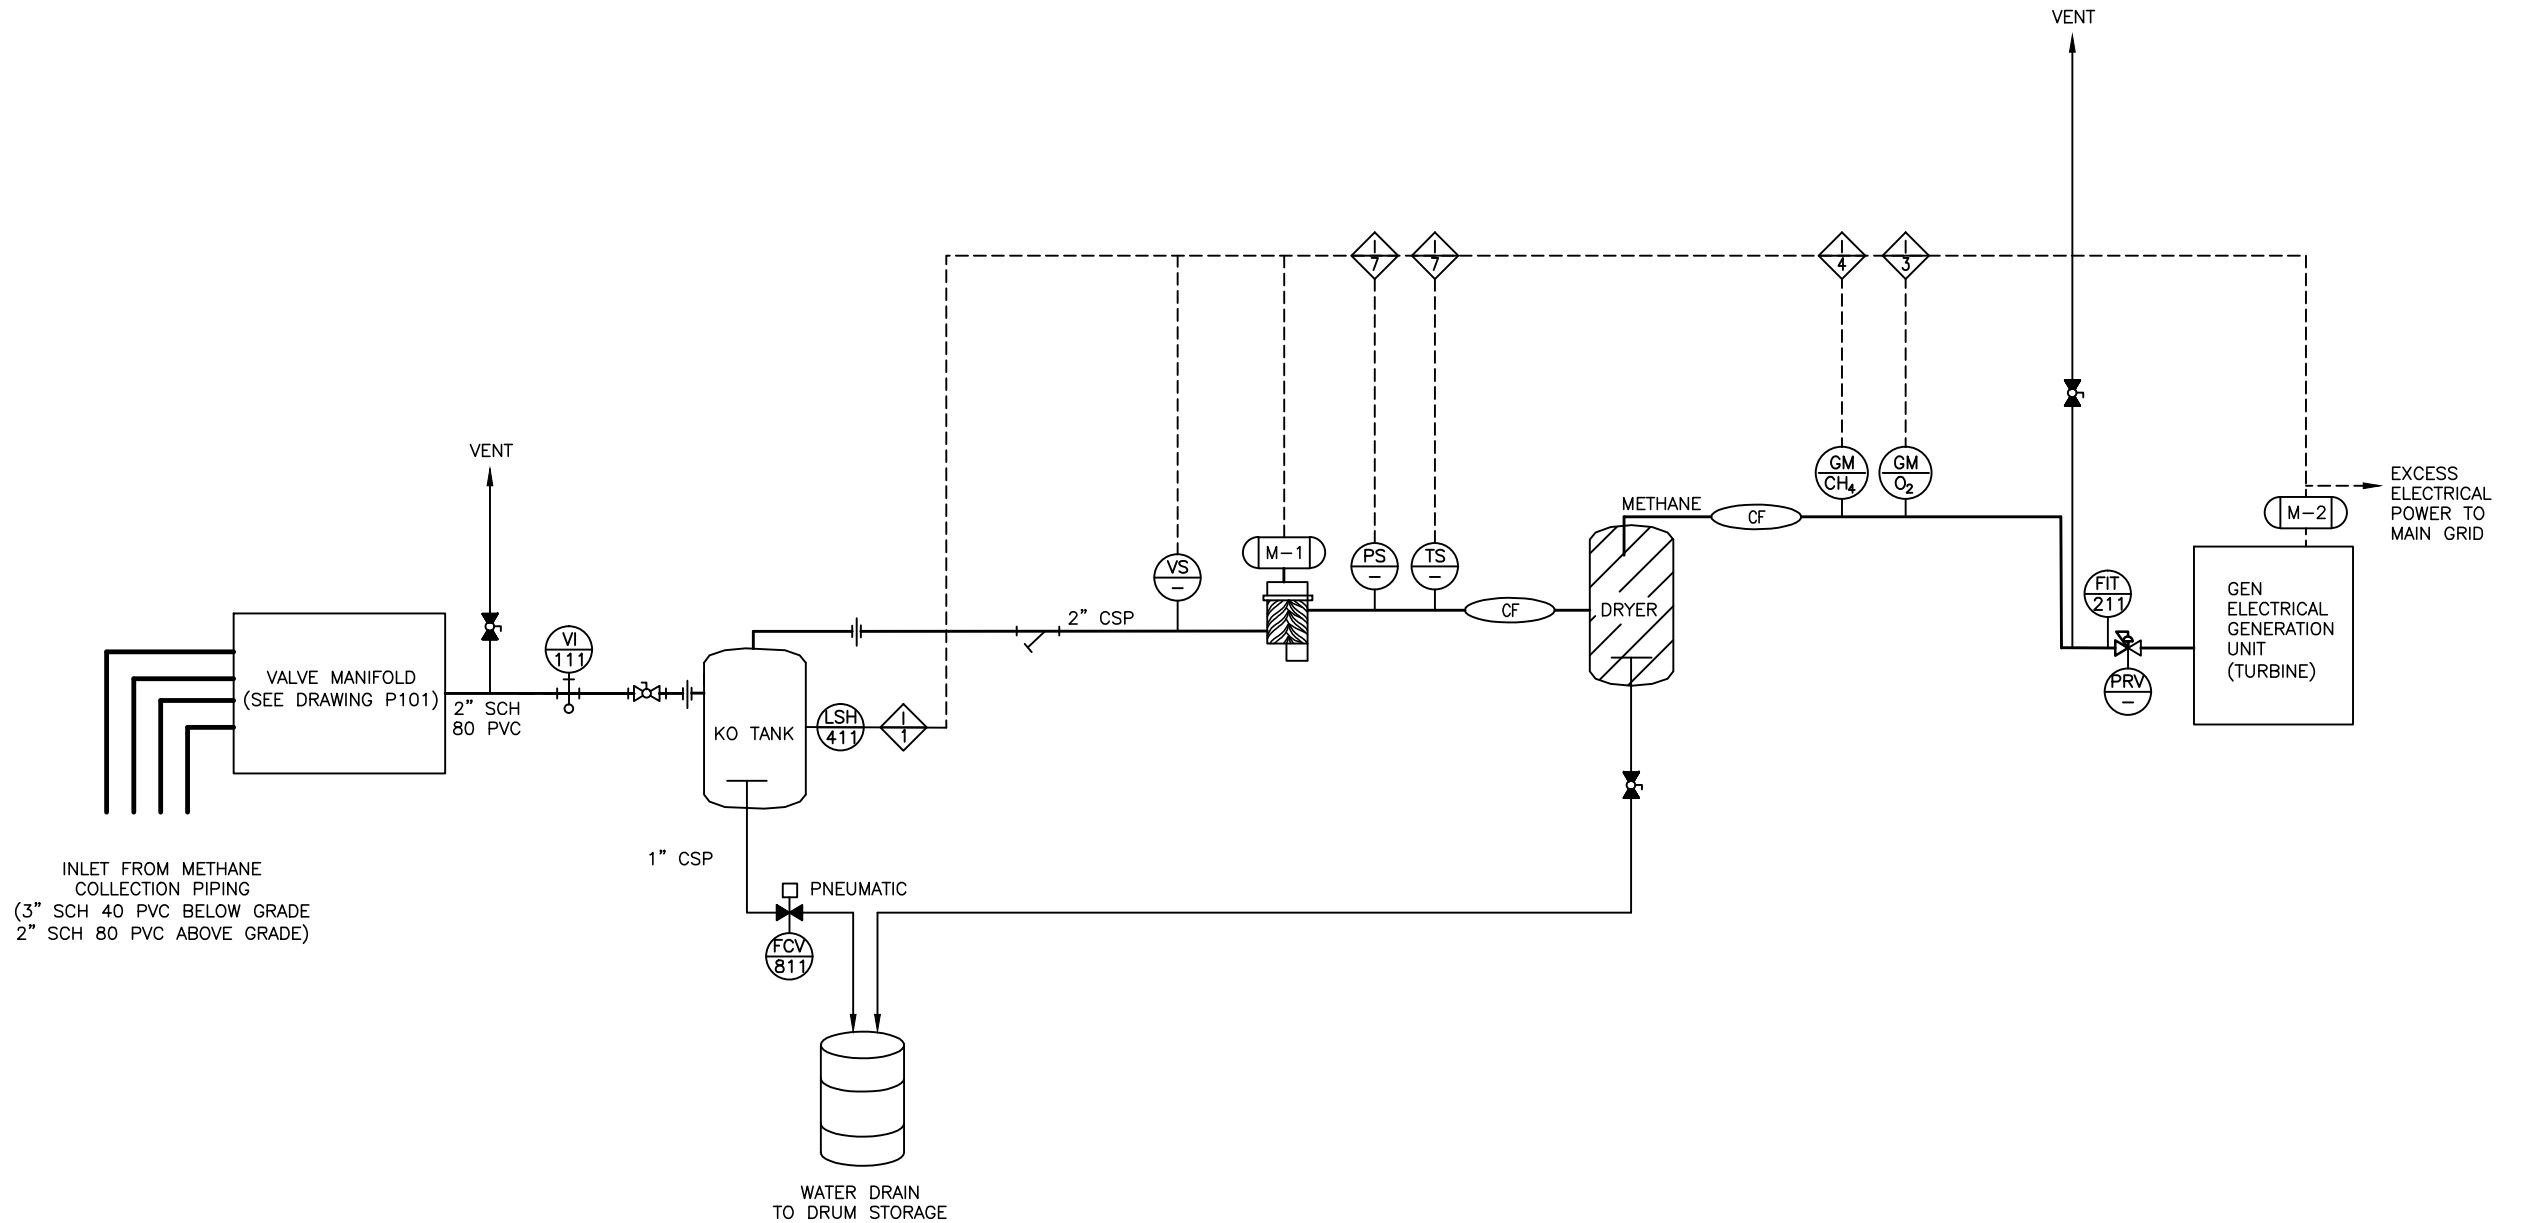


REVISIONS				
NO.	DESCRIPTION	BY	APPROVED	DATE
C	AS-BUILT	MRV	CES	9/4/09
B	FINAL DESIGN	MRV	CES	10/1/08
A	PRELIMINARY DESIGN	MRV	CES	7/14/08

DRAWING INFORMATION	BY	DATE
DESIGNED	MRV	9/4/09
DRAWN	GVM	9/4/09
CHECKED	MRV	9/4/09
REVIEWED	CES	9/4/09
APPROVED	CES	9/4/09
FILE: OGCC081\AS-BUILT\ P100		
SCALE: AS SHOWN		



PROCESS FLOW AND INSTRUMENTATION DIAGRAM SITE 1 – SOUTH FORK TEXAS CREEK 4M OUTCROP MITIGATION DURANGO, COLORADO		
PROJECT LOCATION: DURANGO, COLORADO		PROJECT NO. OGCC0801
CLIENT: COLORADO OIL AND GAS CONSERVATION COMMISSION	REV NO. C	DWG NO. P100

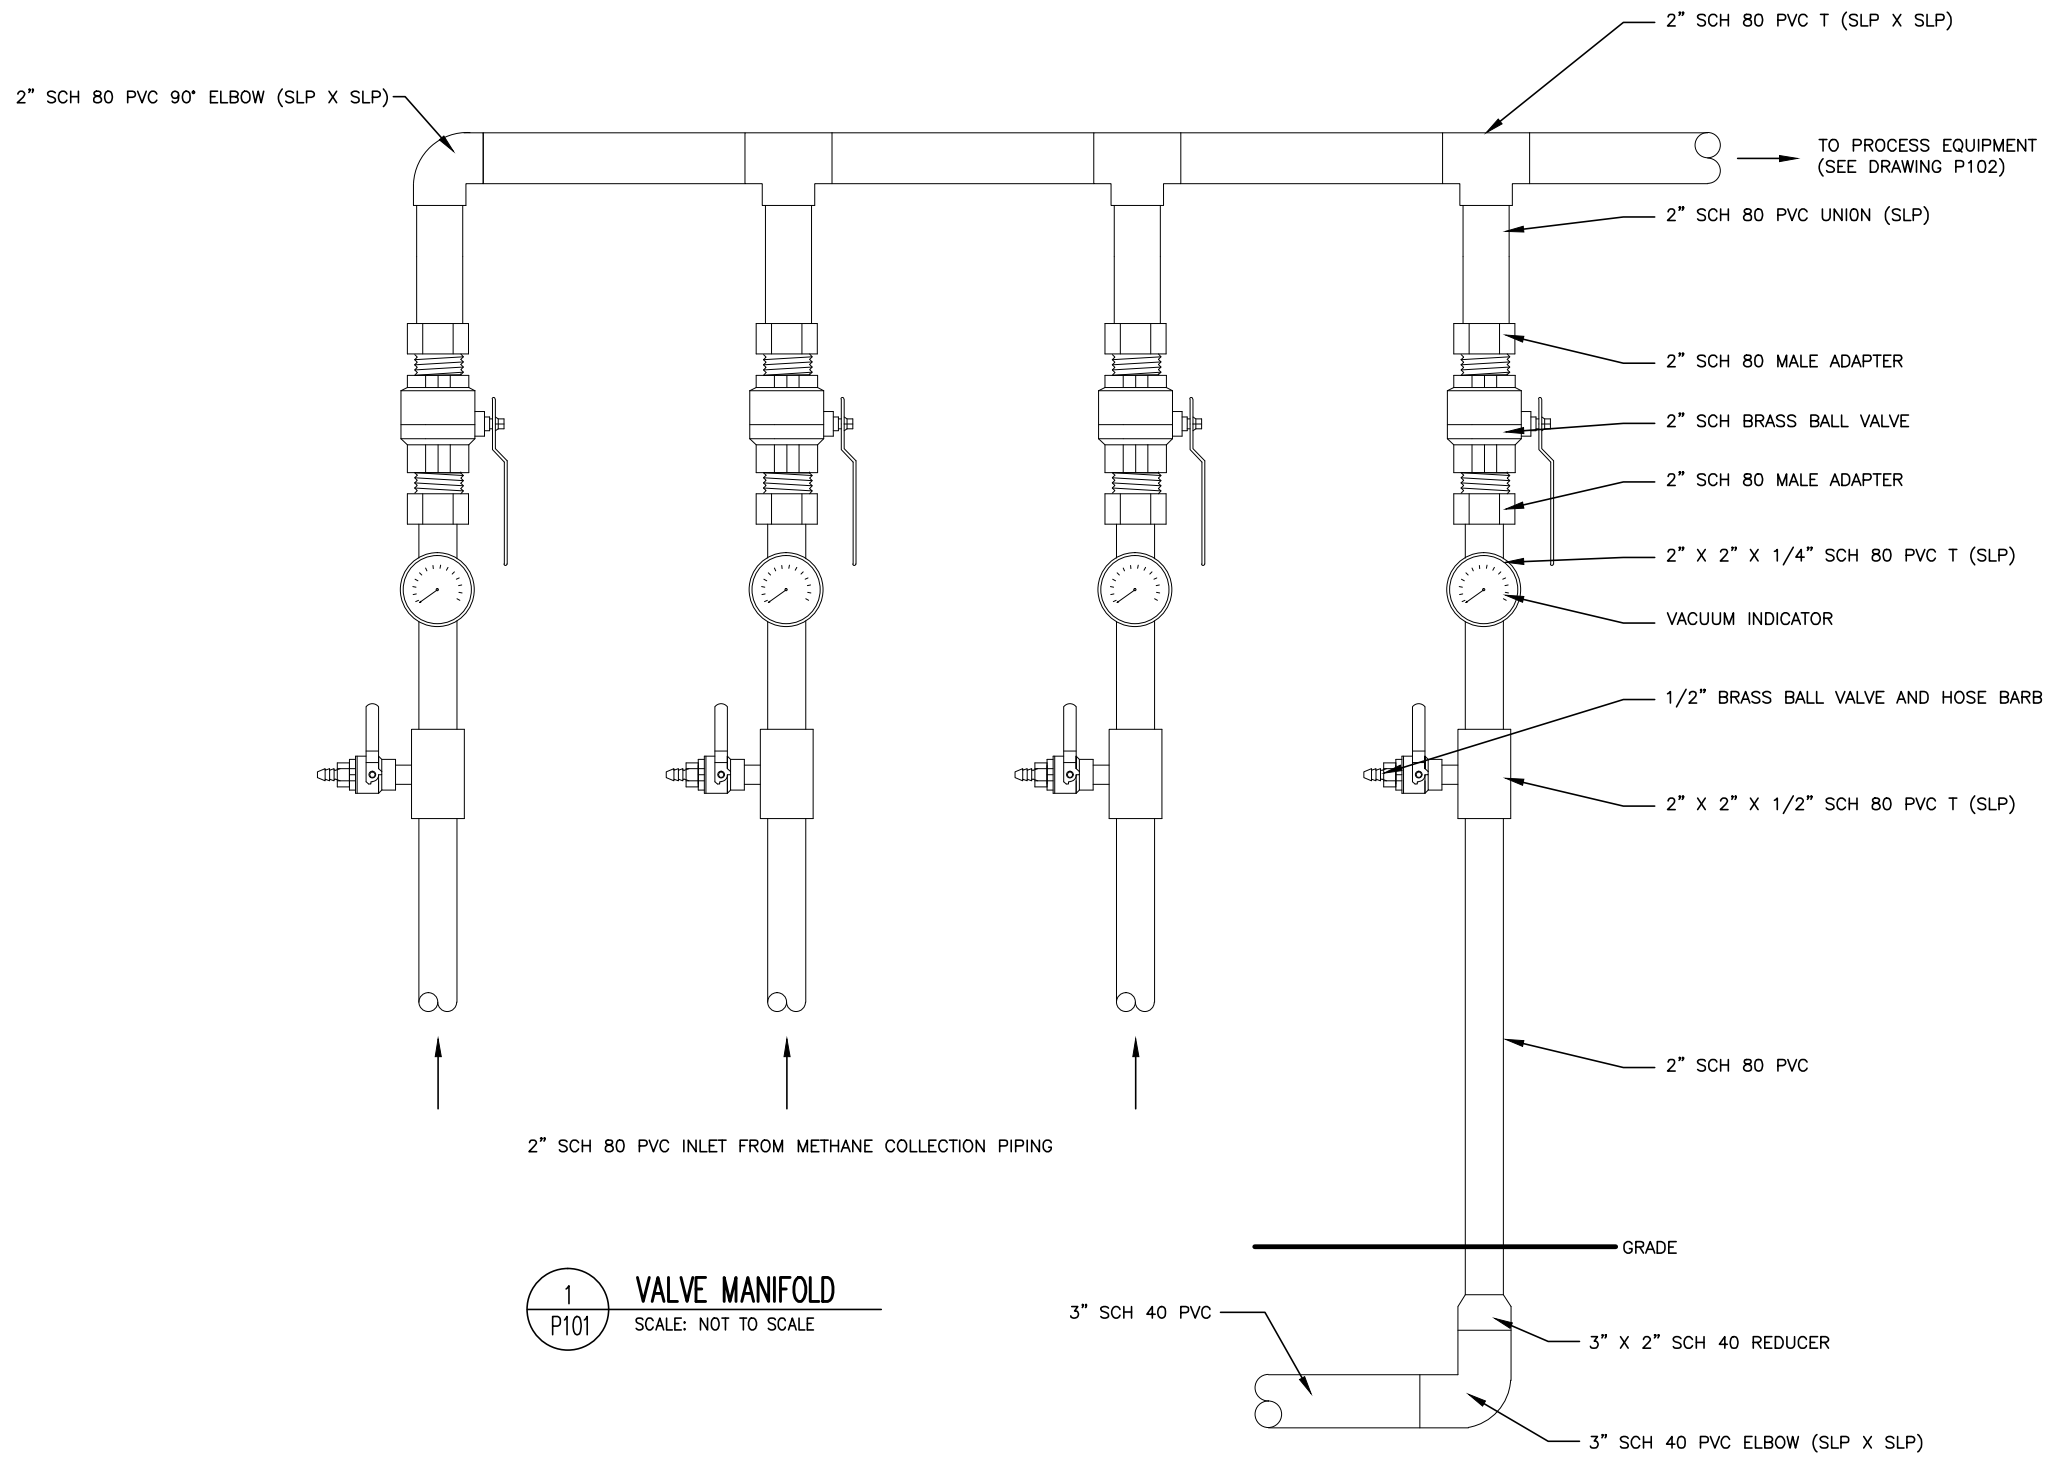


1 VALVE MANIFOLD
 P101 SCALE: NOT TO SCALE

REVISIONS				
NO.	DESCRIPTION	BY	APPROVED	DATE
C	AS-BUILT	MRV	CES	9/4/09
B	FINAL DESIGN	MRV	CES	10/1/08
A	PRELIMINARY DESIGN	MRV	CES	7/14/08

DRAWING INFORMATION	BY	DATE
DESIGNED	MRV	9/4/09
DRAWN	GVM	9/4/09
CHECKED	MRV	9/4/09
REVIEWED	CES	9/4/09
APPROVED	CES	9/4/09
FILE: OGCC081\AS-BUILT\ P101		
SCALE: AS SHOWN		



VALVE MANIFOLD SITE 1 – SOUTH FORK TEXAS CREEK 4M OUTCROP MITIGATION DURANGO, COLORADO		
PROJECT LOCATION: DURANGO, COLORADO		PROJECT NO. OGCC0801
CLIENT:	REV NO.	DWG NO.
COLORADO OIL AND GAS CONSERVATION COMMISSION	C	P101

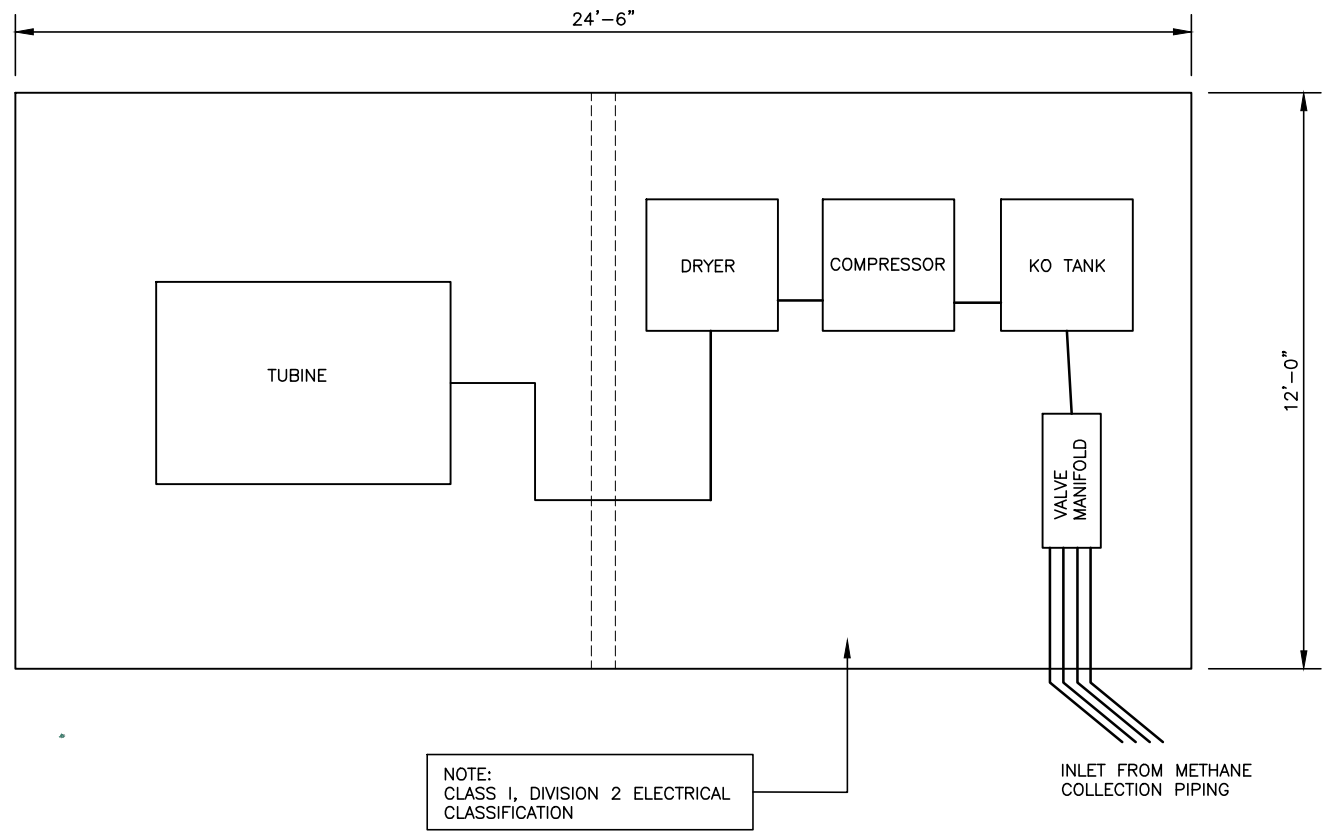

1
P102


PROCESS EQUIPMENT LAYOUT
SCALE: NOT TO SCALE

REVISIONS				
NO.	DESCRIPTION	BY	APPROVED	DATE
C	AS-BUILT	MRV	CES	9/4/09
B	FINIAL DESIGN	MRV	CES	10/1/08
A	PRELIMINARY DESIGN	MRV	CES	7/14/08

DRAWING INFORMATION	BY	DATE
DESIGNED	MRV	9/4/09
DRAWN	GVM	9/4/09
CHECKED	MRV	9/4/09
REVIEWED	CES	9/4/09
APPROVED	CES	9/4/09
FILE: OGCC081\AS-BUILT\P102		
SCALE: AS SHOWN		




PROCESS EQUIPMENT LAYOUT SITE 1 – SOUTH FORK TEXAS CREEK 4M OUTCROP MITIGADO DURANGO, COLORADO		
PROJECT LOCATION: DURANGO, COLORADO	PROJECT NO. OGCC0801	
CLIENT: COLORADO OIL AND GAS CONSERVATION COMMISSION	REV NO. C	DWG NO. P102

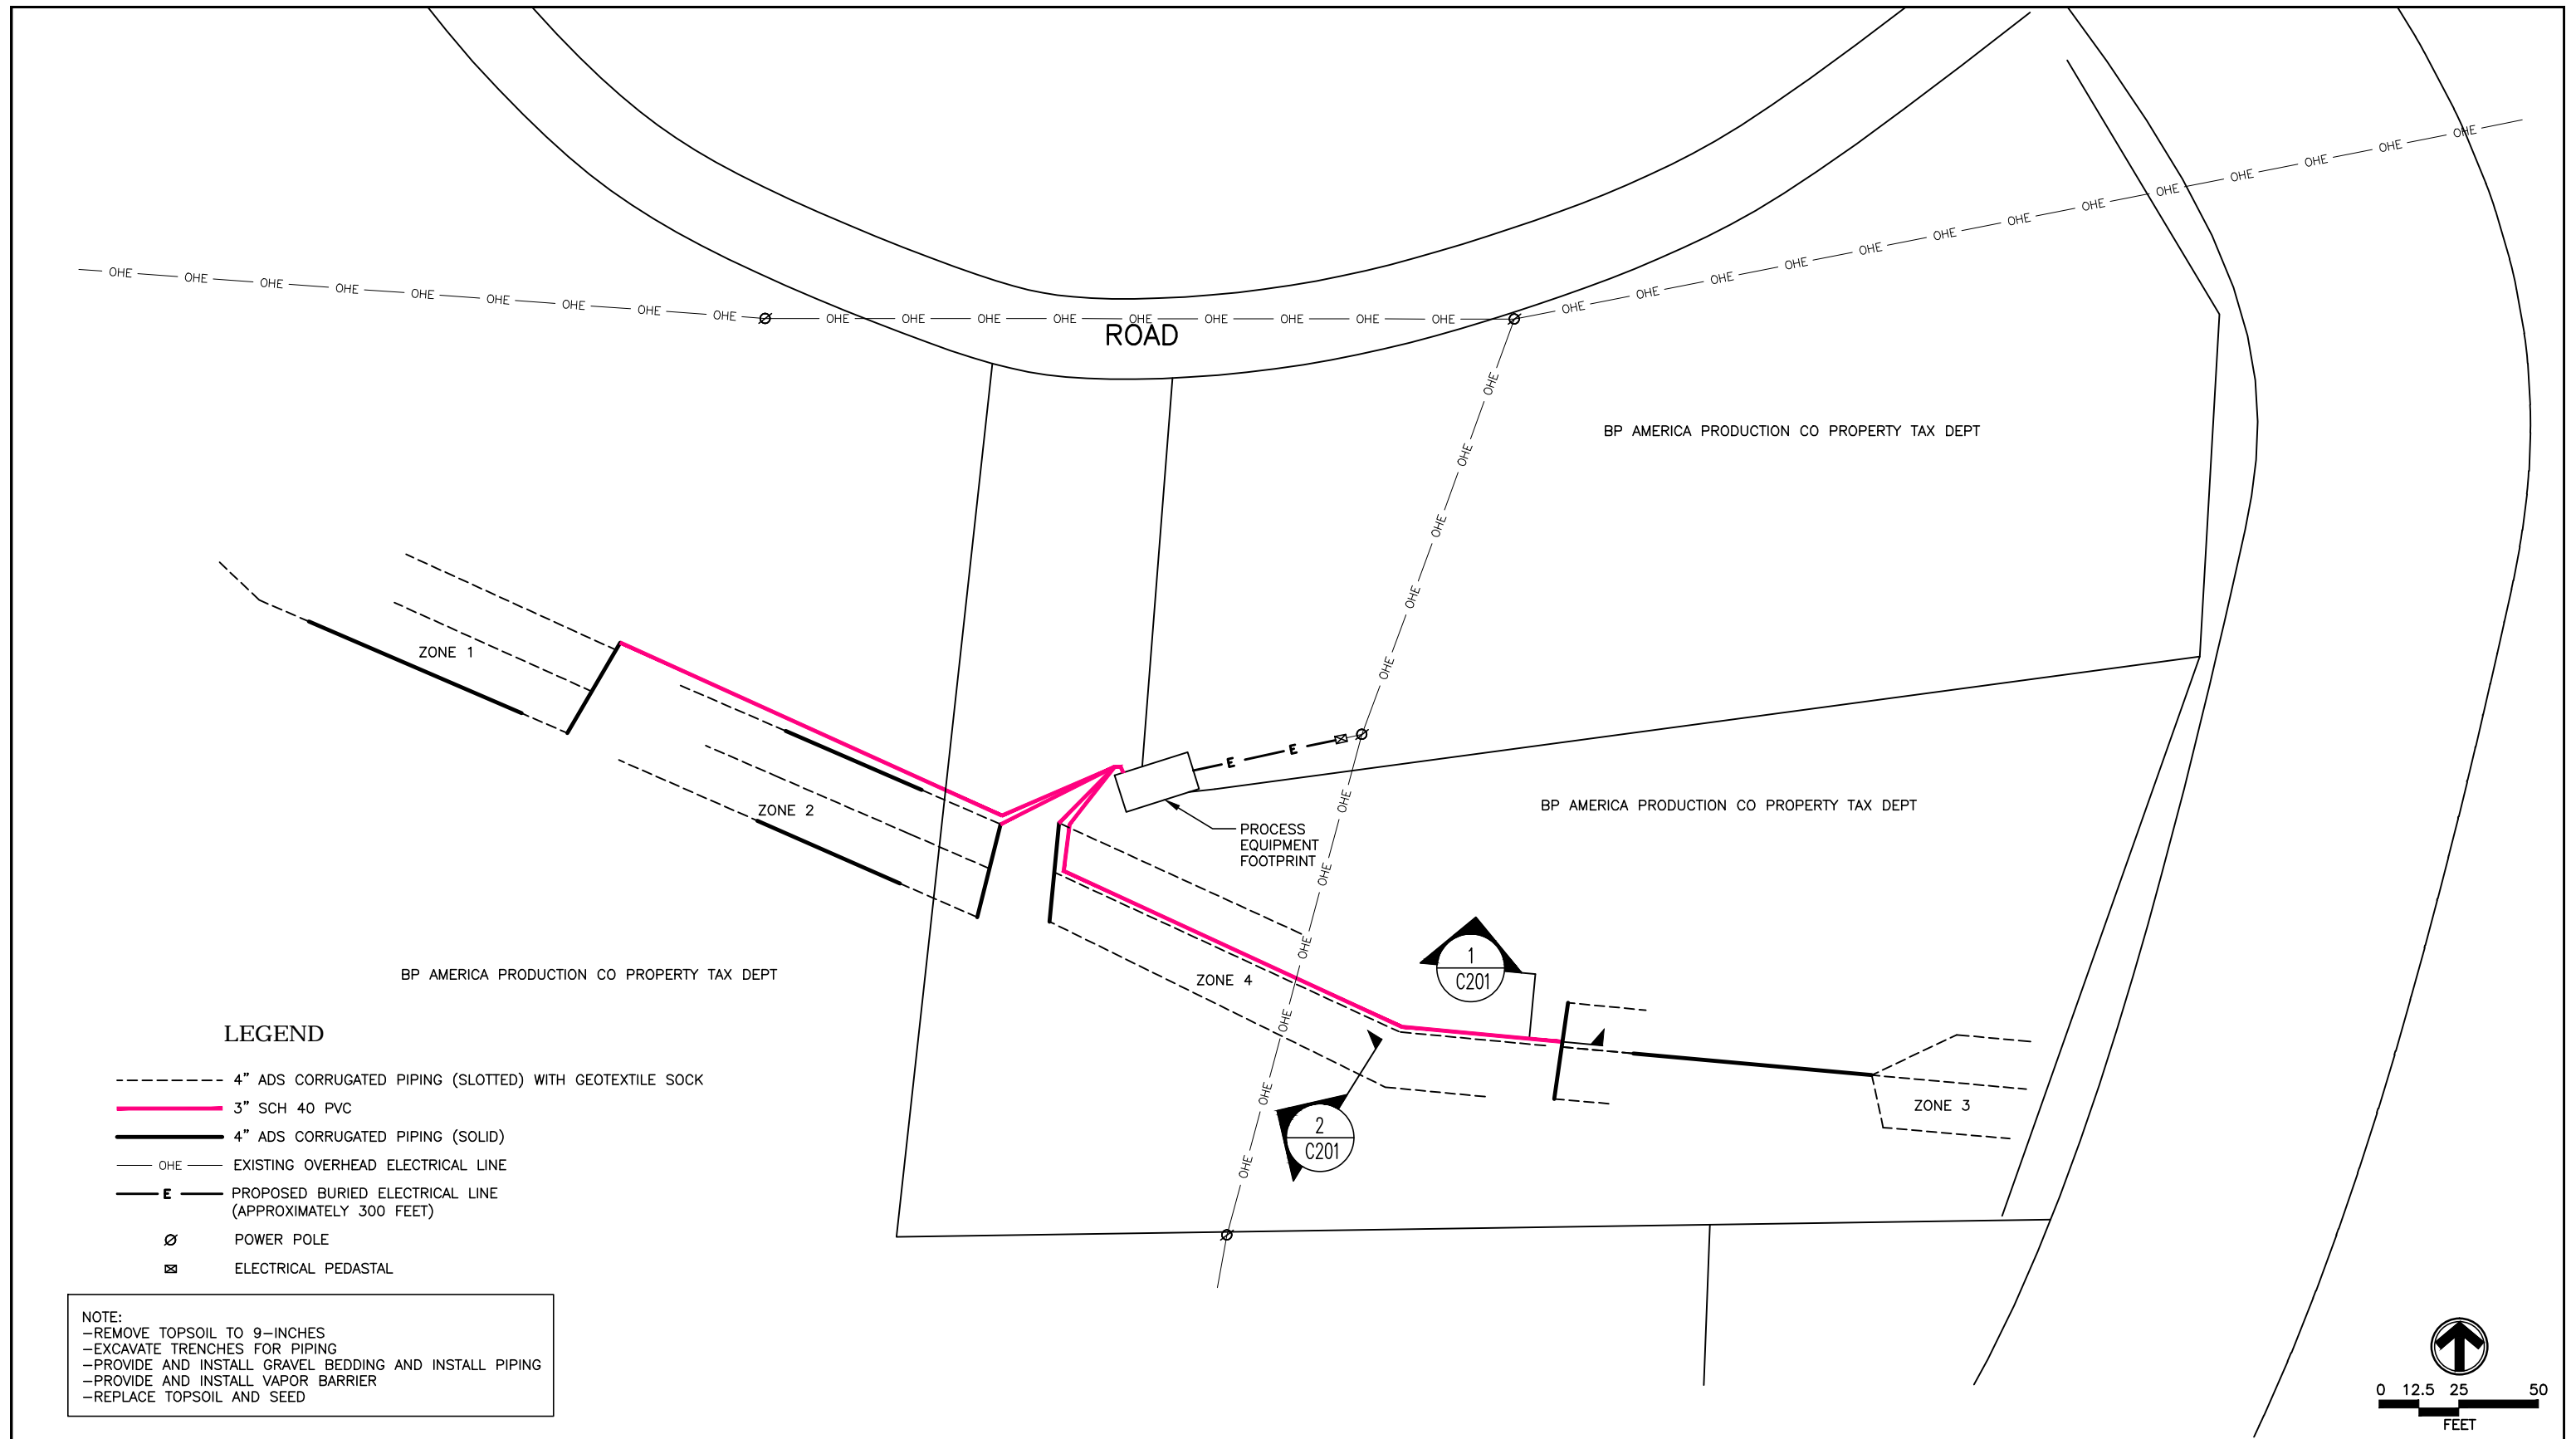

LEGEND

- 4" ADS CORRUGATED PIPING (SLOTTED) WITH GEOTEXTILE SOCK
- 3" SCH 40 PVC
- 4" ADS CORRUGATED PIPING (SOLID)
- OHE — EXISTING OVERHEAD ELECTRICAL LINE
- E — PROPOSED BURIED ELECTRICAL LINE (APPROXIMATELY 300 FEET)
- ⊘ POWER POLE
- ⊠ ELECTRICAL PEDASTAL

NOTE:
 -REMOVE TOPSOIL TO 9-INCHES
 -EXCAVATE TRENCHES FOR PIPING
 -PROVIDE AND INSTALL GRAVEL BEDDING AND INSTALL PIPING
 -PROVIDE AND INSTALL VAPOR BARRIER
 -REPLACE TOPSOIL AND SEED

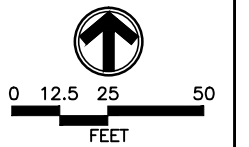


REVISIONS				
NO.	DESCRIPTION	BY	APPROVED	DATE
C	AS-BUILT	MRV	CES	9/4/09
B	FINAL DESIGN	MRV	CES	10/1/08
A	PRELIMINARY DESIGN	MRV	CES	7/14/08

DRAWING INFORMATION	BY	DATE
DESIGNED	MRV	9/4/09
DRAWN	GVM	9/4/09
CHECKED	MRV	9/4/09
REVIEWED	CES	9/4/09
APPROVED	CES	9/4/09


FILE: OGCC081\AS-BUILT\C100
 SCALE: AS SHOWN



MITIGATION PIPING LAYOUT		
SITE 2 – PINE RIVER		
4M OUTCROP MITIGATION		
DURANGO, COLORADO		
PROJECT LOCATION: DURANGO, COLORADO	PROJECT NO. OGCC0801	
CLIENT: COLORADO OIL AND GAS CONSERVATION COMMISSION	REV NO. C	DWG NO. C200

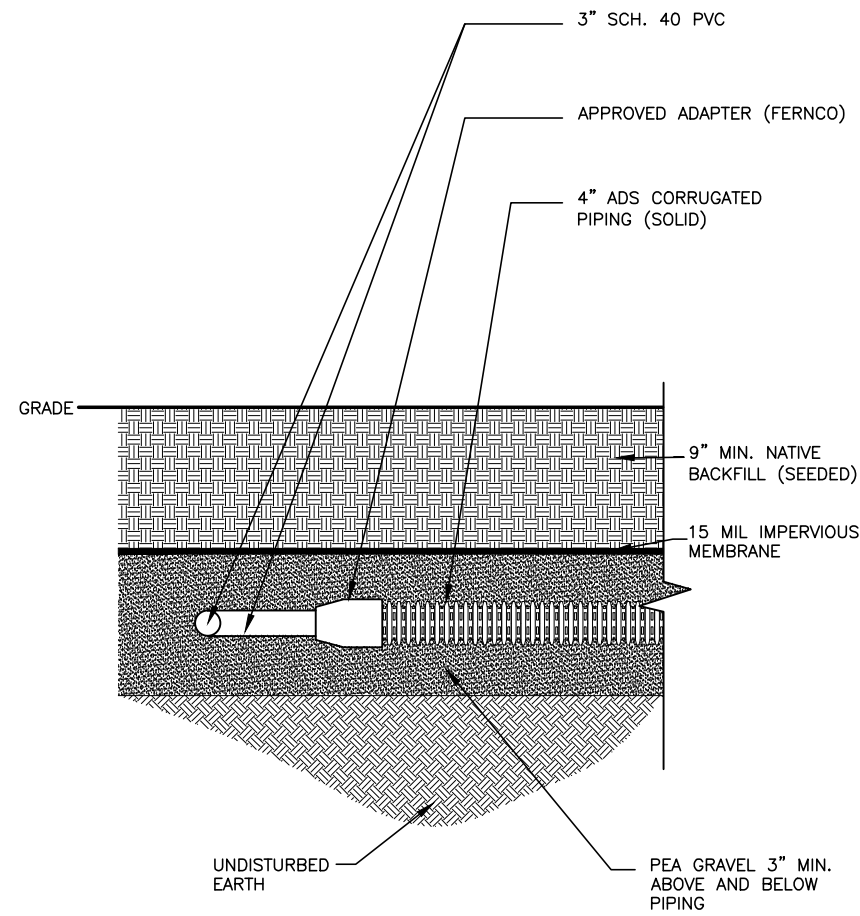

1 PIPING CONNECTION AT HEADER
SCALE: 1" = 1'-0"

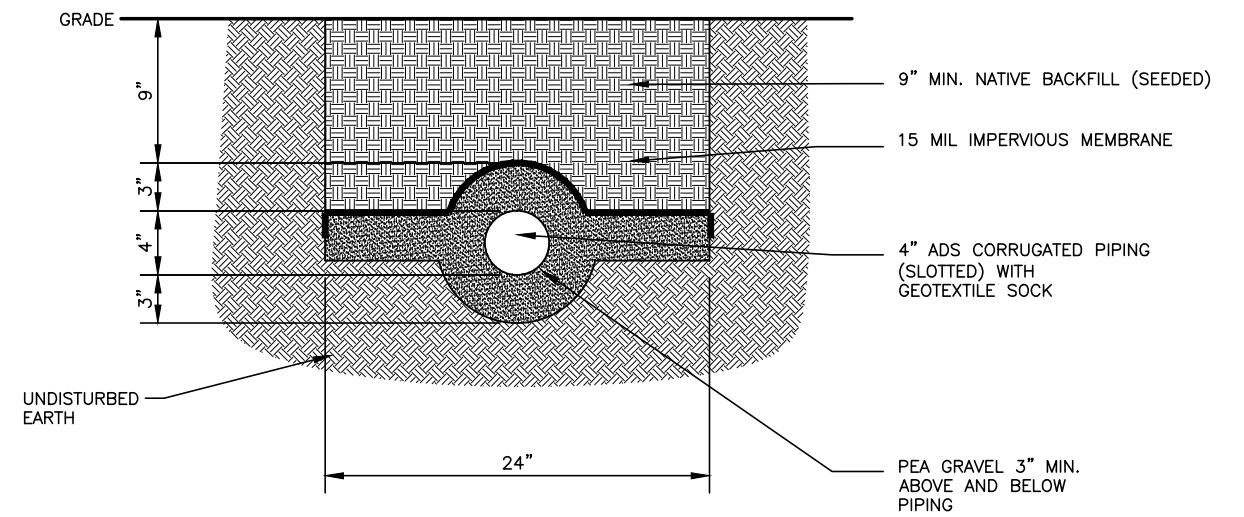

2 HORIZONTAL VENT LINE CROSS SECTION
SCALE: 1" = 1'-0"


REVISIONS				
NO.	DESCRIPTION	BY	APPROVED	DATE
C	AS-BUILT	MRV	CES	9/4/09
B	FINAL DESIGN	MRV	CES	10/1/08
A	PRELIMINARY DESIGN	MRV	CES	7/14/08

DRAWING INFORMATION	BY	DATE
DESIGNED	MRV	9/4/09
DRAWN	GVM	9/4/09
CHECKED	MRV	9/4/09
REVIEWED	CES	9/4/09
APPROVED	CES	9/4/09

FILE: OGCC081\AS-BUILT\C201
SCALE: AS SHOWN



PIPING DIAGRAM SITE 2 - PINE RIVER 4M OUTCROP MITIGATION DURANGO, COLORADO	
PROJECT LOCATION: DURANGO, COLORADO	PROJECT NO. OGCC0801
CLIENT: COLORADO OIL AND GAS CONSERVATION COMMISSION	REV NO. C DWG NO. C201

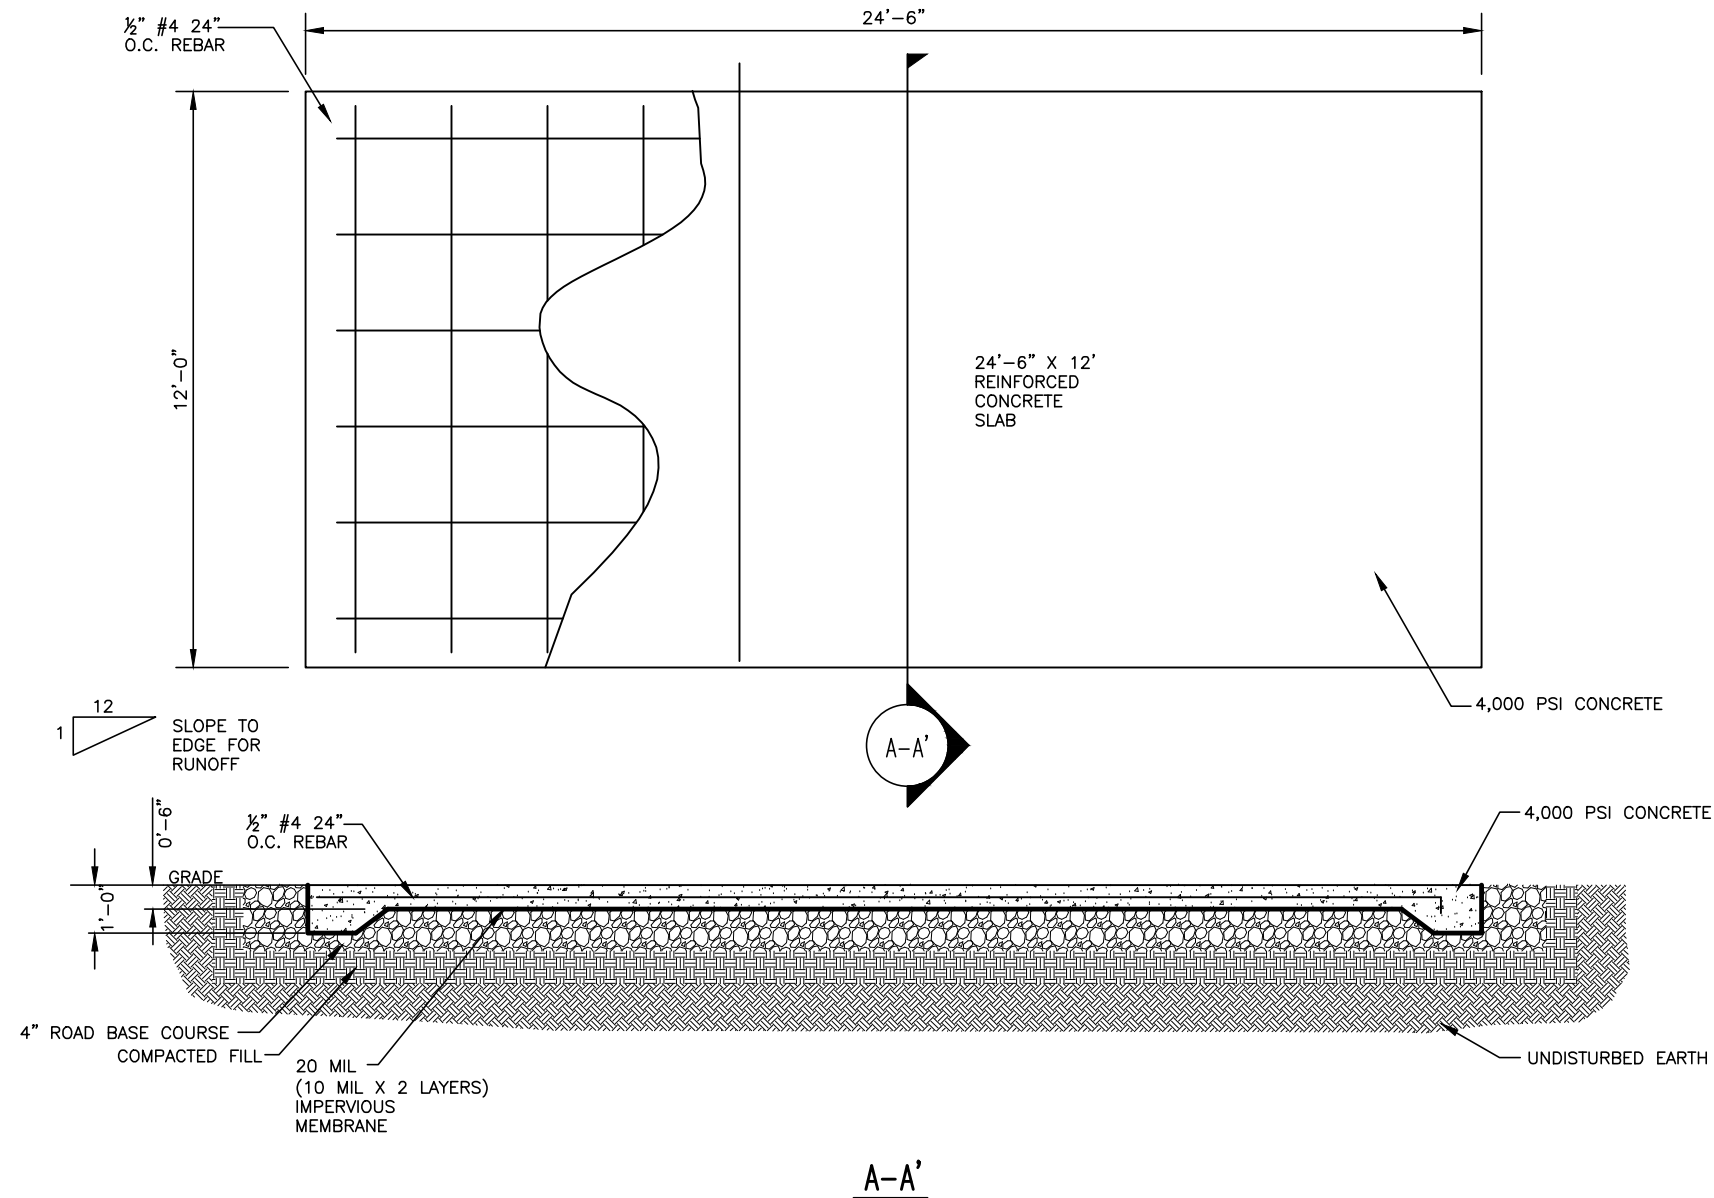

1
C202

CONCRETE PADS DETAILS

SCALE: 1/4" = 1'-0"

REVISIONS				
NO.	DESCRIPTION	BY	APPROVED	DATE
C	AS-BUILT	MRV	CES	9/4/09
B	FINAL DESIGN	MRV	CES	10/1/08
A	PRELIMINARY DESIGN	MRV	CES	7/14/08


DRAWING INFORMATION	BY	DATE
DESIGNED	MRV	9/4/09
DRAWN	GVM	9/4/09
CHECKED	MRV	9/4/09
REVIEWED	CES	9/4/09
APPROVED	CES	9/4/09

FILE: OGCC081\AS-BUILT\C202

SCALE: AS SHOWN




CONCRETE PAD DETAILS		
SITE 2 - PINE RIVER		
4M OUTCROP MITIGATION		
DURANGO, COLORADO		
PROJECT LOCATION: DURANGO, COLORADO		PROJECT NO. OGCC0801
CLIENT:	REV NO.	DWG NO.
COLORADO OIL AND GAS CONSERVATION COMMISSION	C	C202

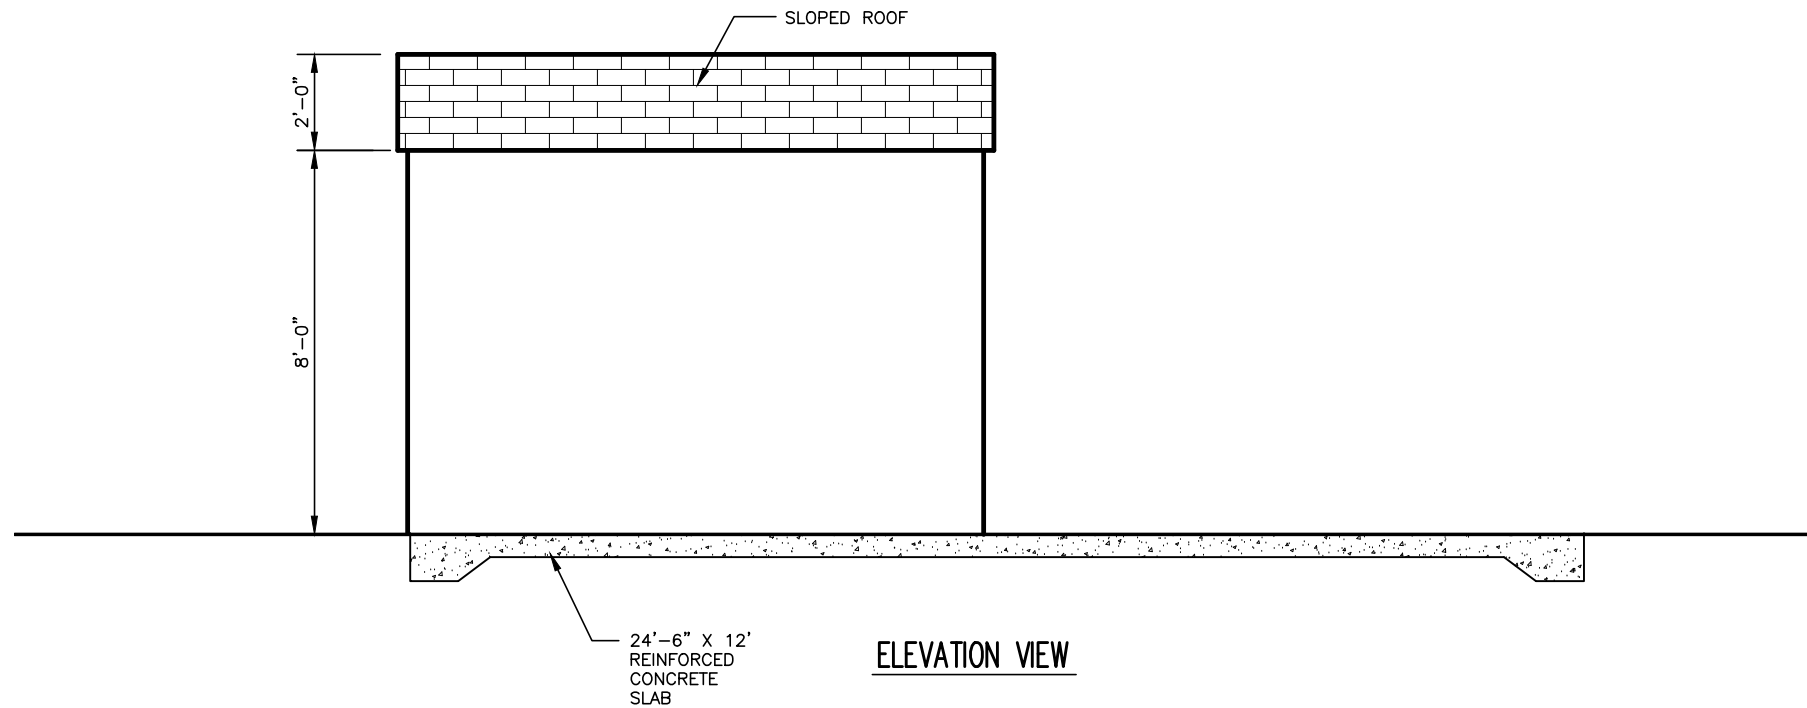

2
C203

EQUIPMENT BUILDING
SCALE: 1/4" = 1'-0"

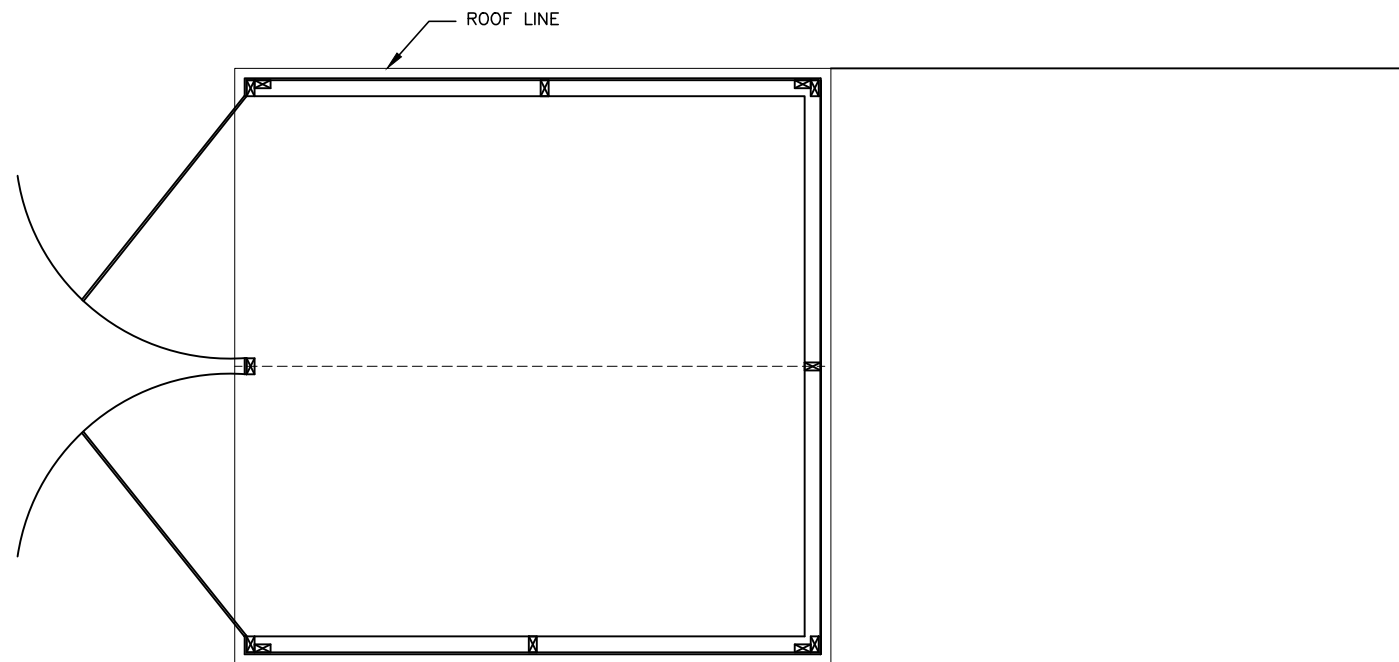

NOTE:
 -PROVIDE AND ATTACH "NO SMOKING" SIGNAGE TO BUILDING
 -PROVIDE APPROPRIATE FIRE EXTINGUISHER FOR SITE
 -PROVIDE INSULATION FOR ACOUSTICAL DAMPENING
 -ANCHOR BUILDING TO CONCRETE PER MANUFACTURER RECOMMENDATIONS
 -ADEQUATE VENTILATION SHALL BE PROVIDED FOR BUILDING














REVISIONS				
NO.	DESCRIPTION	BY	APPROVED	DATE
C	AS-BUILT	MRV	CES	9/4/09
B	FINAL DESIGN	MRV	CES	10/1/08
A	PRELIMINARY DESIGN	MRV	CES	7/14/08


DRAWING INFORMATION	BY	DATE
DESIGNED	MRV	9/4/09
DRAWN	GVM	9/4/09
CHECKED	MRV	9/4/09
REVIEWED	CES	9/4/09
APPROVED	CES	9/4/09
FILE: OGCC081\AS-BUILT\C203		
SCALE: AS SHOWN		

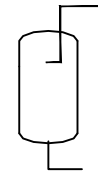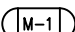

EQUIPMENT BUILDING DETAILS		
SITE 2 - PINE RIVER		
4M OUTCROP MITIGATION		
DURANGO, COLORADO		
PROJECT LOCATION: DURANGO, COLORADO	PROJECT NO. OGCC0801	
CLIENT: COLORADO OIL AND GAS CONSERVATION COMMISSION	REV NO. C	DWG NO. C203

LEGEND

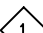-  BALL VALVE (NO)
-  BALL VALVE (NC)
-  1/2" PLUGGED SAMPLING PORT
-  UNION
-  KNOCKOUT TANK
- CSP CARBON STEEL PIPE
- PVC POLYVINYL CHLORIDE PIPE
-  MOTOR
-  FILTER
-  VACUUM INDICATOR
-  HIGH LEVEL SWITCH
-  FLOW INDICATOR/TOTALIZER
-  GAS MONITOR
- ELECTRICAL CONNECTION
-  BLOWER
-  INTERLOCK ELECTRICAL CONTROL

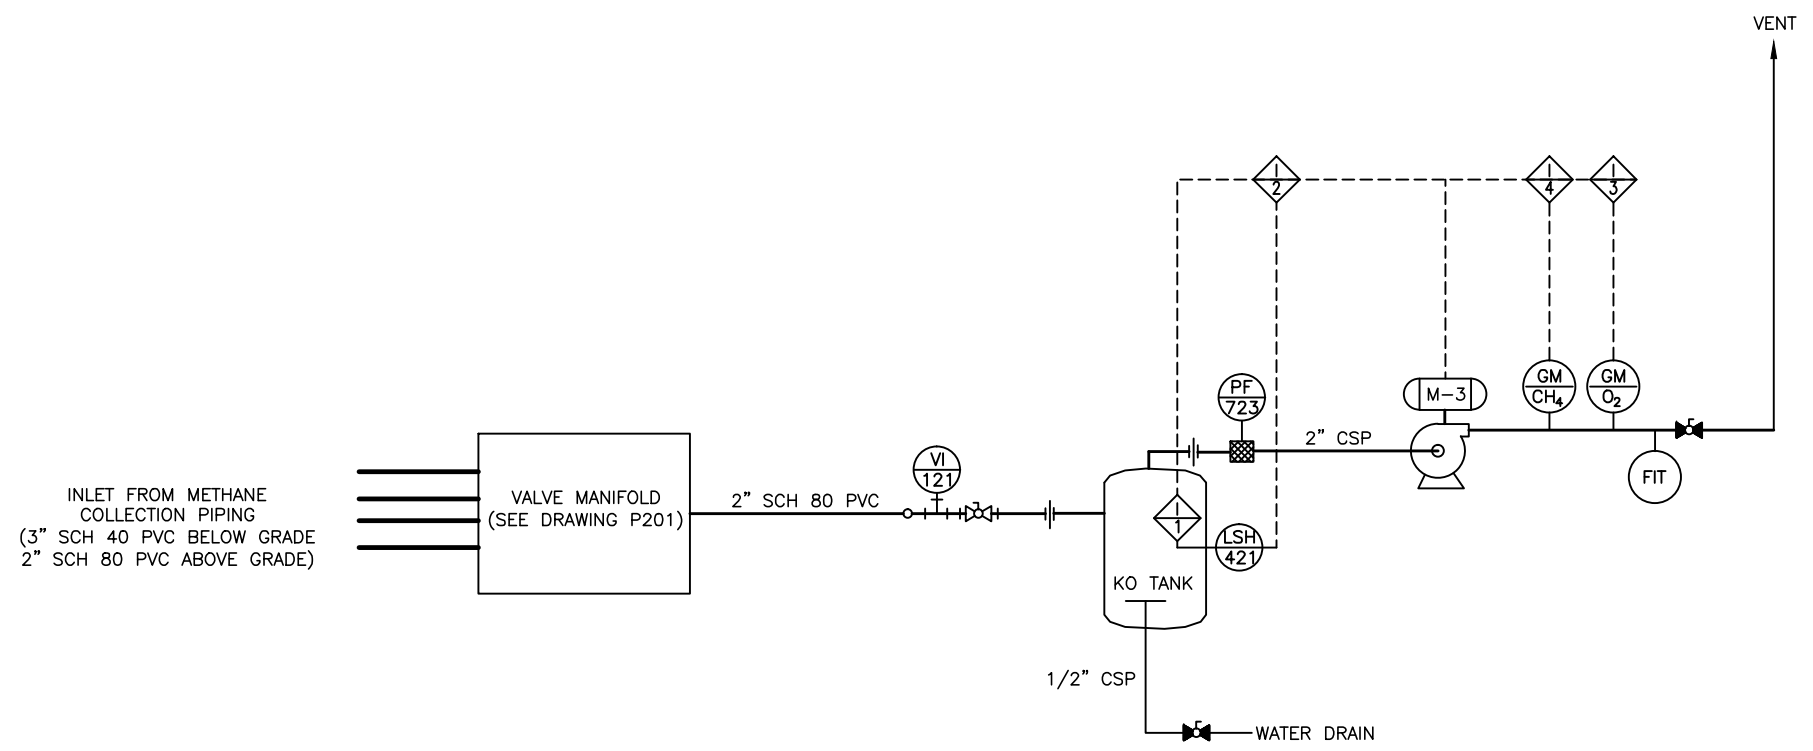


REVISIONS				
NO.	DESCRIPTION	BY	APPROVED	DATE
C	AS-BUILT	MRV	CES	9/4/09
B	FINAL DESIGN	MRV	CES	10/1/08
A	PRELIMINARY DESIGN	MRV	CES	7/14/08

INLET FROM METHANE COLLECTION PIPING (3" SCH 40 PVC BELOW GRADE 2" SCH 80 PVC ABOVE GRADE)
VALVE MANIFOLD (SEE DRAWING P201)
KO TANK
WATER DRAIN

DRAWING INFORMATION	BY	DATE
DESIGNED	MRV	9/4/09
DRAWN	GVM	9/4/09
CHECKED	MRV	9/4/09
REVIEWED	CES	9/4/09
APPROVED	CES	9/4/09
FILE: OGCC081\AS-BUILT\P200		
SCALE: AS SHOWN		



PROCESS FLOW AND INSTRUMENTATION DIAGRAM SITE 2 – PINE RIVER 4M OUTCROP MITIGATION DURANGO, COLORADO		
PROJECT LOCATION: DURANGO, COLORADO		PROJECT NO. OGCC0801
CLIENT: COLORADO OIL AND GAS CONSERVATION COMMISSION	REV NO. C	DWG NO. P200

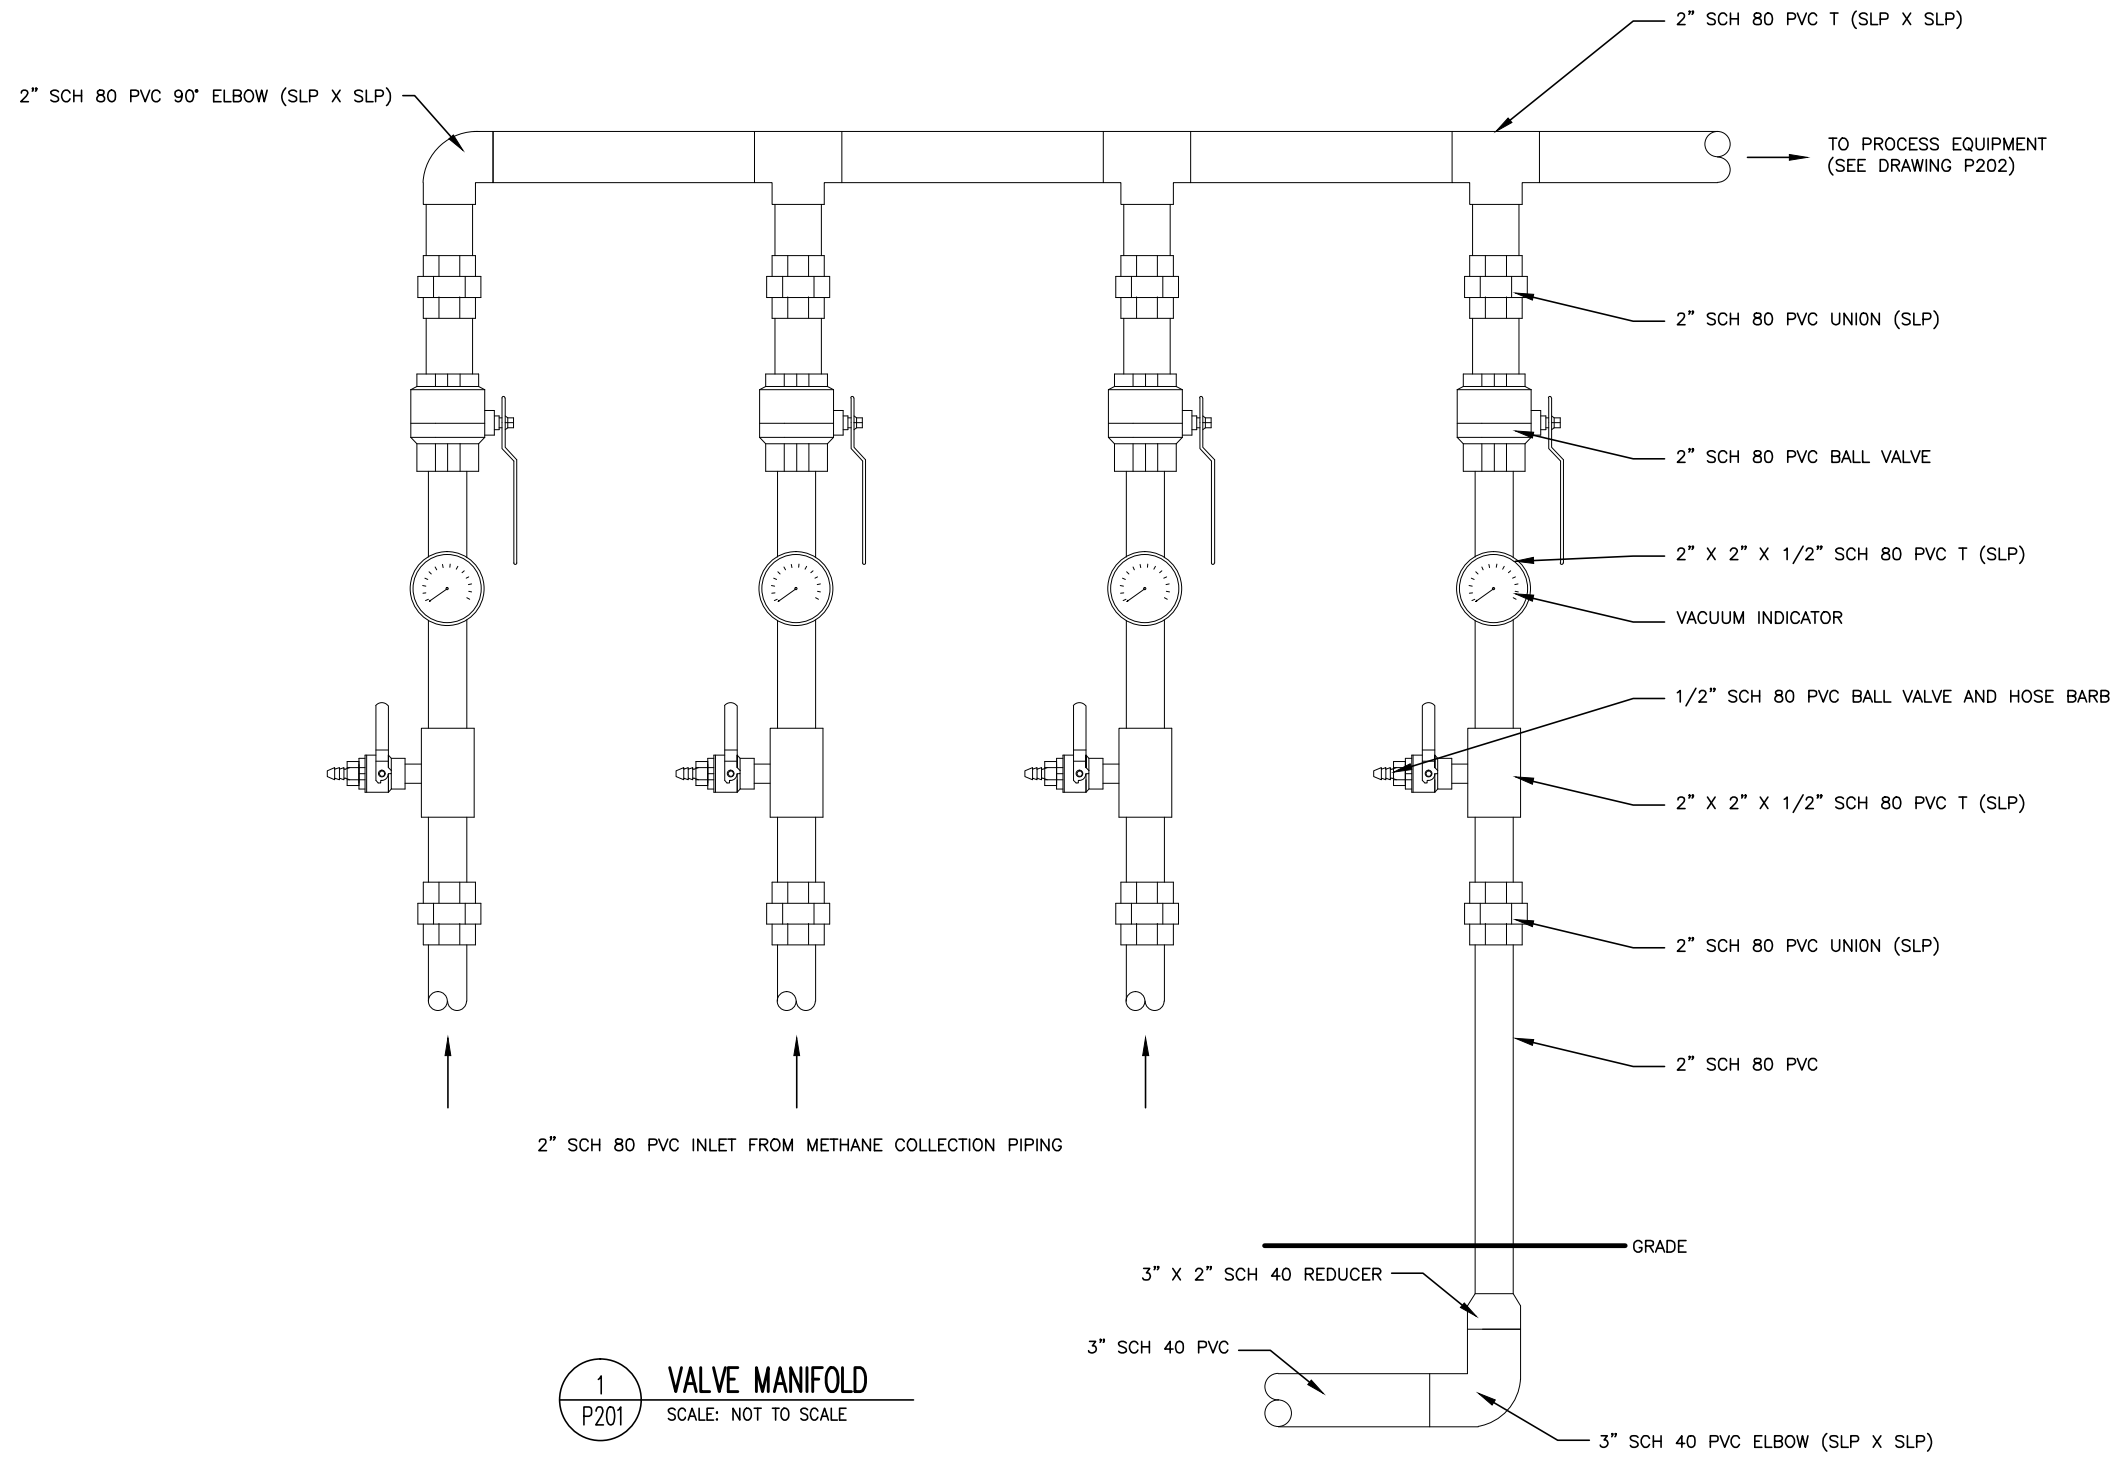


1
P201 VALVE MANIFOLD
SCALE: NOT TO SCALE

REVISIONS				
NO.	DESCRIPTION	BY	APPROVED	DATE
C	AS-BUILT	MRV	CES	9/4/09
B	FINAL DESIGN	MRV	CES	10/1/08
A	PRELIMINARY DESIGN	MRV	CES	7/14/08

DRAWING INFORMATION	BY	DATE
DESIGNED	MRV	9/4/09
DRAWN	GVM	9/4/09
CHECKED	MRV	9/4/09
REVIEWED	CES	9/4/09
APPROVED	CES	9/4/09
FILE: OGCC081\AS-BUILT\P201		
SCALE: AS SHOWN		



VALVE MANIFOLD SITE 2 – PINE RIVER 4M OUTCROP MITIGATION DURANGO, COLORADO		
PROJECT LOCATION: DURANGO, COLORADO		PROJECT NO. OGCC0801
CLIENT: COLORADO OIL AND GAS CONSERVATION COMMISSION	REV NO. C	DWG NO. P201

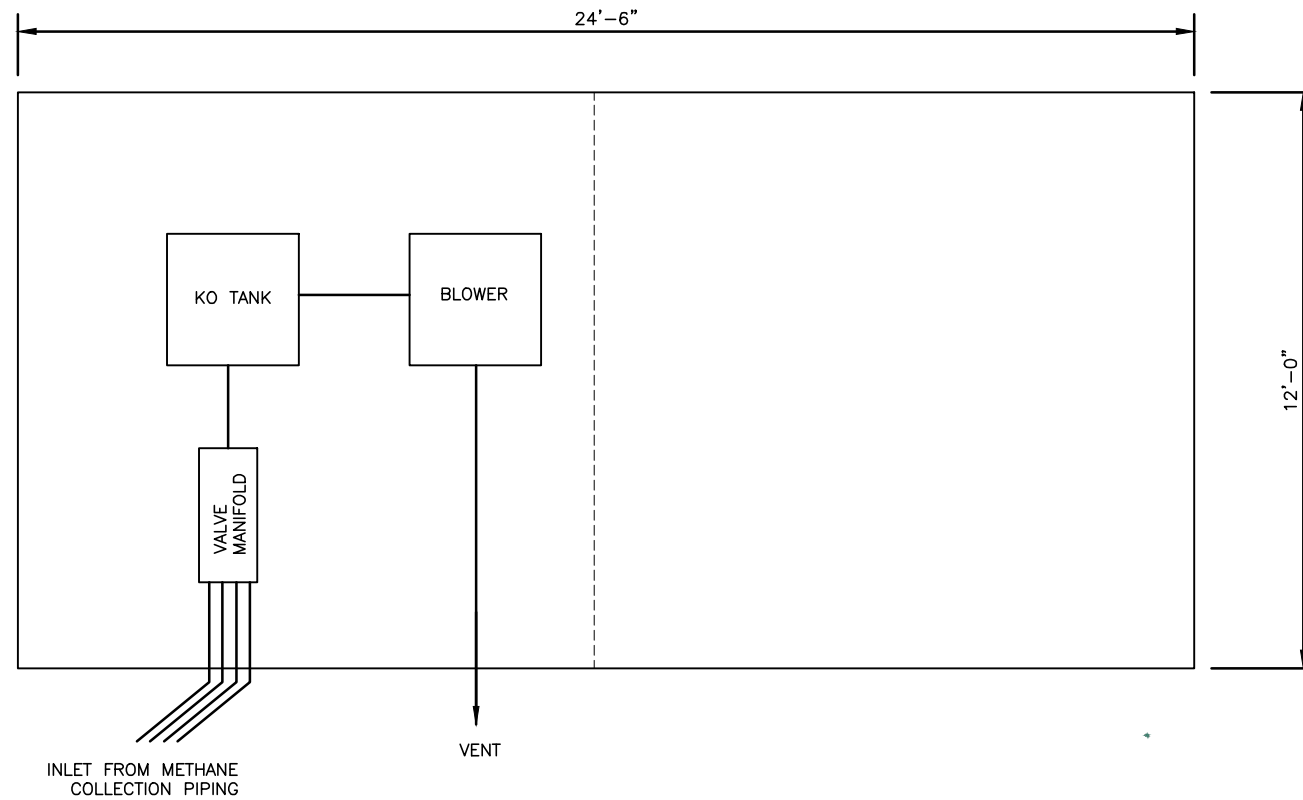

NOTE:
CLASS I, DIVISION 2 ELECTRICAL
CLASSIFICATION

1 PROCESS EQUIPMENT LAYOUT
P202 SCALE: NOT TO SCALE

REVISIONS				
NO.	DESCRIPTION	BY	APPROVED	DATE
C	AS-BUILT	MRV	CES	9/4/09
B	FINIAL DESIGN	MRV	CES	10/1/08
A	PRELIMINARY DESIGN	MRV	CES	7/14/08

DRAWING INFORMATION	BY	DATE
DESIGNED	MRV	9/4/09
DRAWN	GVM	9/4/09
CHECKED	MRV	9/4/09
REVIEWED	CES	9/4/09
APPROVED	CES	9/4/09
FILE: OGCC081\AS-BUILT\P202		
SCALE: AS SHOWN		



PROCESS EQUIPMENT LAYOUT SITE 2 – PINE RIVER 4M OUTCROP MITIGATION DURANGO, COLORADO		
PROJECT LOCATION: DURANGO, COLORADO	PROJECT NO. OGCC0801	
CLIENT: COLORADO OIL AND GAS CONSERVATION COMMISSION	REV NO. C	DWG NO. P202